


T.29S.R.15E.W.M.

SE 1/4 SECTION 9

1" = 400'

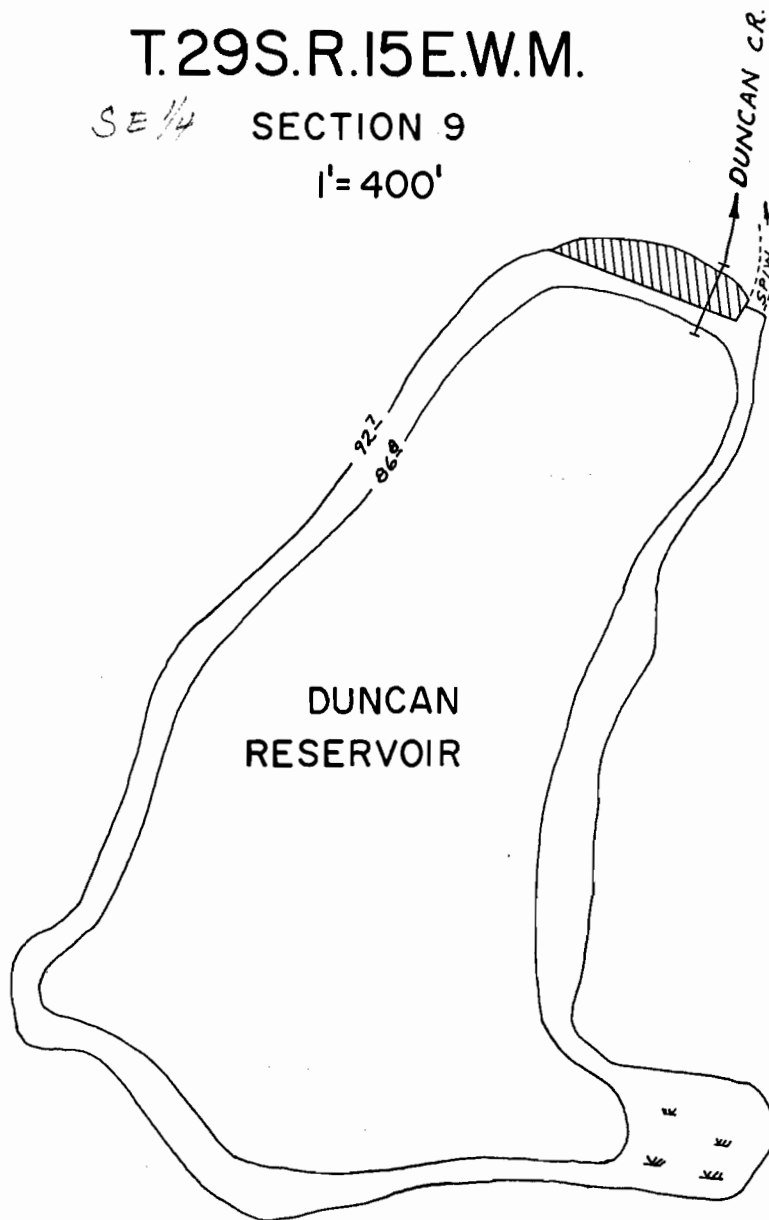

FINAL PROOF SURVEY
UNDER

Application No. *R-48211* Permit No. *R-5837*
48212 *36075*
IN NAME OF

BUREAU OF LAND MANAGEMENT

Surveyed *OCT. 26, 1976*, by *R. MUCKEN*