


37752
46983
#1 49462
see
not page

T.39S.R.18&19E.W.M.

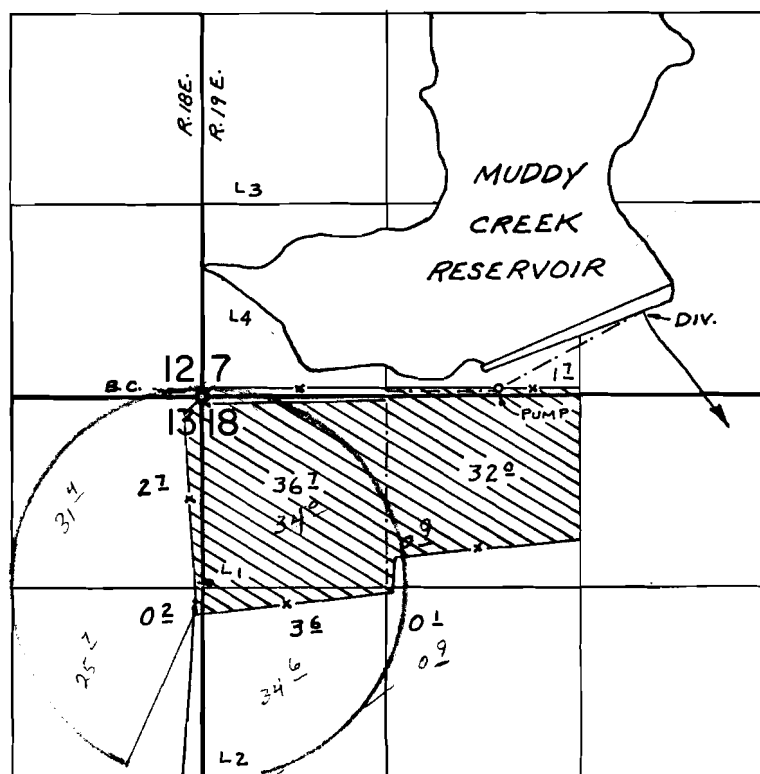

DIV. LOC: 600' N. & 3015 E. FROM S.W. COR. SEC. 7

FINAL PROOF SURVEY UNDER


Application No. 51208... Permit No. 37752...
IN NAME OF

.....CHARLES K. KELLEY.....

Surveyed OCT. 23, 1976, by R. MUCKEN

P37752

T.39S.R.18&19E.W.M.

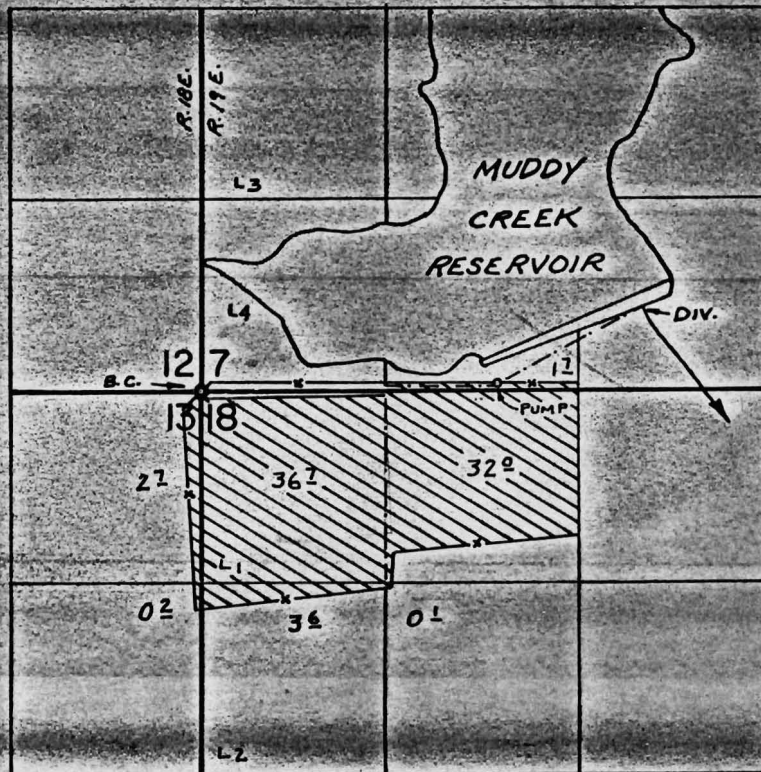

DIV. LOC: 600' N. & 3015 E. FROM S.W. COR. SEC. 7

cert #
49462

FINAL PROOF SURVEY UNDER

Application No. 51200... Permit No. 37752...
IN NAME OF

CHARLES K. KELLEY

Surveyed OCT. 23, 1976, by R. MUCKEN