


T.17S., R.3 W., W.M.

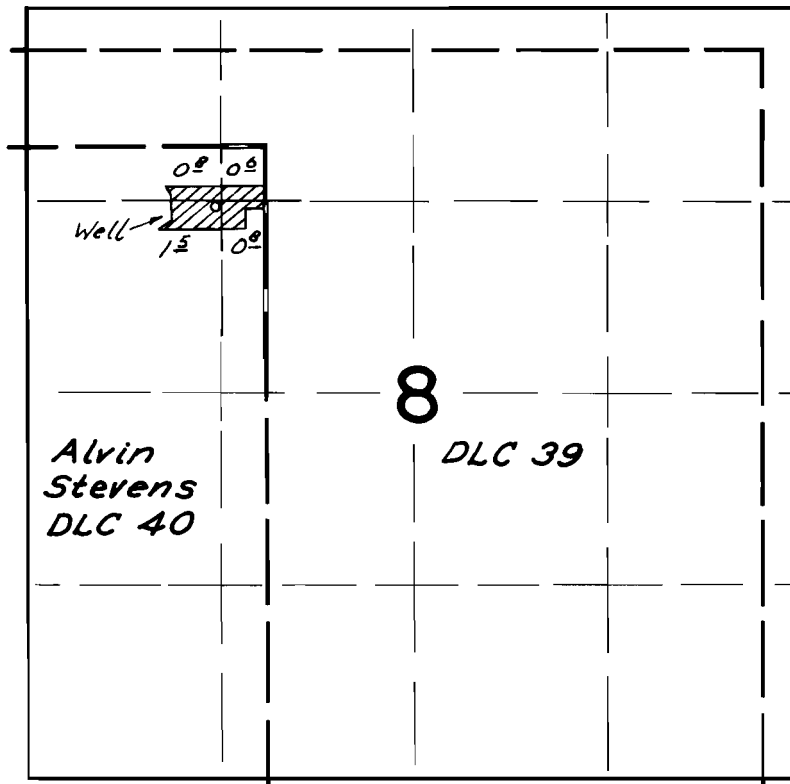

Well Loc: 410'S. & 350'W. from NE Cor. DLC 40

FINAL PROOF SURVEY UNDER

Application No. G-6980 Permit No. G-6080
IN NAME OF

Harris B. Holtan

Surveyed May 20, 1976, by D. M. Norby