


T.19 S., R.12 W., W.M.

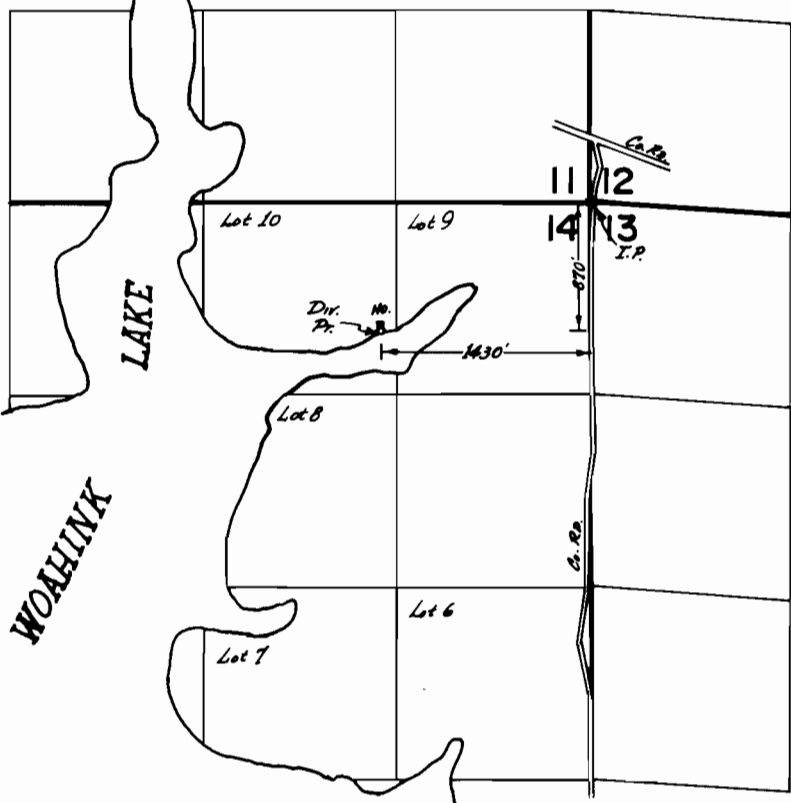

**FINAL PROOF SURVEY**  
UNDER

Application No. 47396 Permit No. 35526  
IN NAME OF

JOHN HARVARD BAKER

Surveyed May 16 1978, by Subordinate