


T.16S. R.7W. W.M.

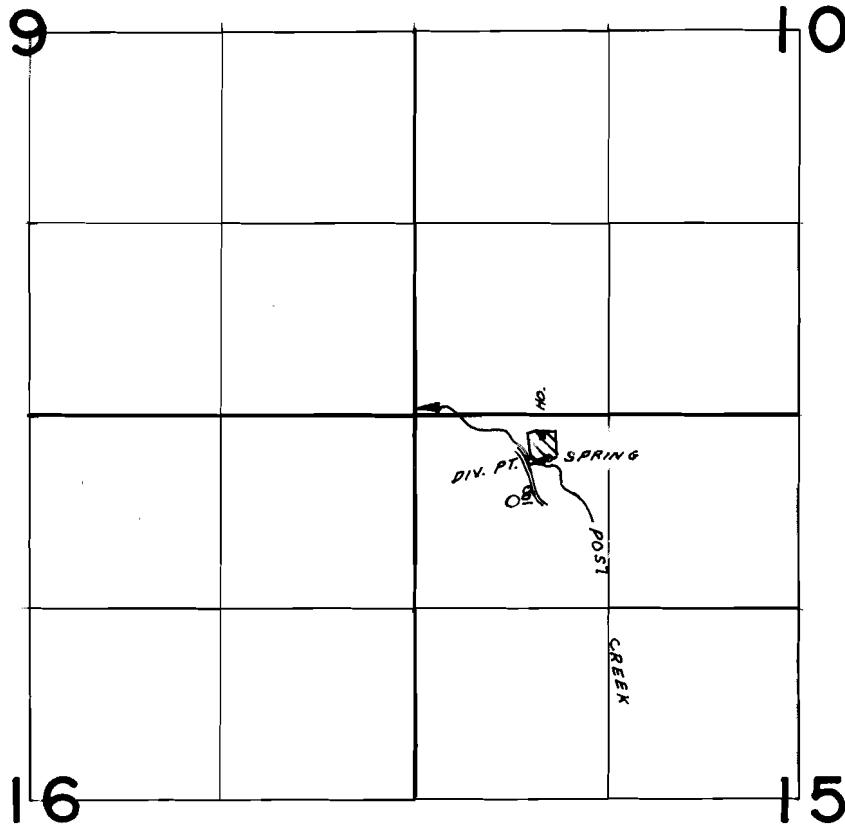

SPRING LOC. 300' S. & 920' E FROM NW COR. SEC. 15.
DIV. PT. LOC. 320' S. & 790' E FROM NW COR. SEC. 15.

FINAL PROOF SURVEY
UNDER

Application No. 50687... Permit No. 38286...
IN NAME OF

HOWARD R. & VIOLA E. JOHNSON

Surveyed MAY 4, 1976, by L.H. NUNN.....