


T.IIS. R.IOW. W.M.

DIV. PTS. PERMIT 39441
 1- 90' N. & 1540' E.
 2- 370' S. & 1740' E.
 3- 3310' S. & 1560' E.
 DIV. PTS. PERMIT 39942
 4- 4120' S. & 1490' E.
 5- 3960' S. & 2740' E.
 6- 4740' S. & 2980' E.
 ALL FROM NW COR.
 SEC. 24.

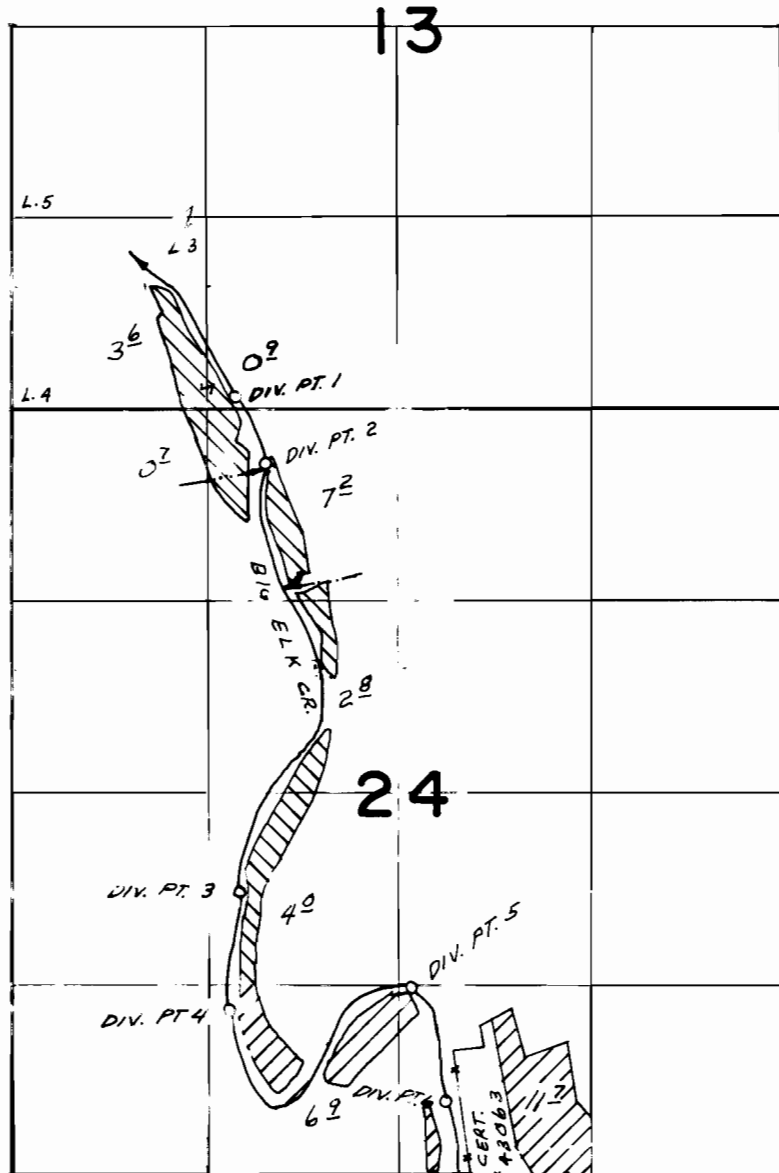

FINAL PROOF SURVEY UNDER

Application No. 52444 Permit No. 39441
 52445 39442
 IN NAME OF

HAROLD L. PARKS

Surveyed AUG. 12, 1976, by L.H. NUNN