

T.IIS. R.IOW. W.M.


13

DIV. PTS. PERMIT 39441

- 1- 90° N. & 1540'E.
2- 370° S. & 1740'E.
3- 3310° S. & 1560'E.

DIV. PTS. PERMIT 39942

- 4- 4120'S. & 1490'E.
5- 3960'S. & 2740'E.
6- 4740'S. & 2980'E.
ALL FROM NW COR.
SEC. 24.

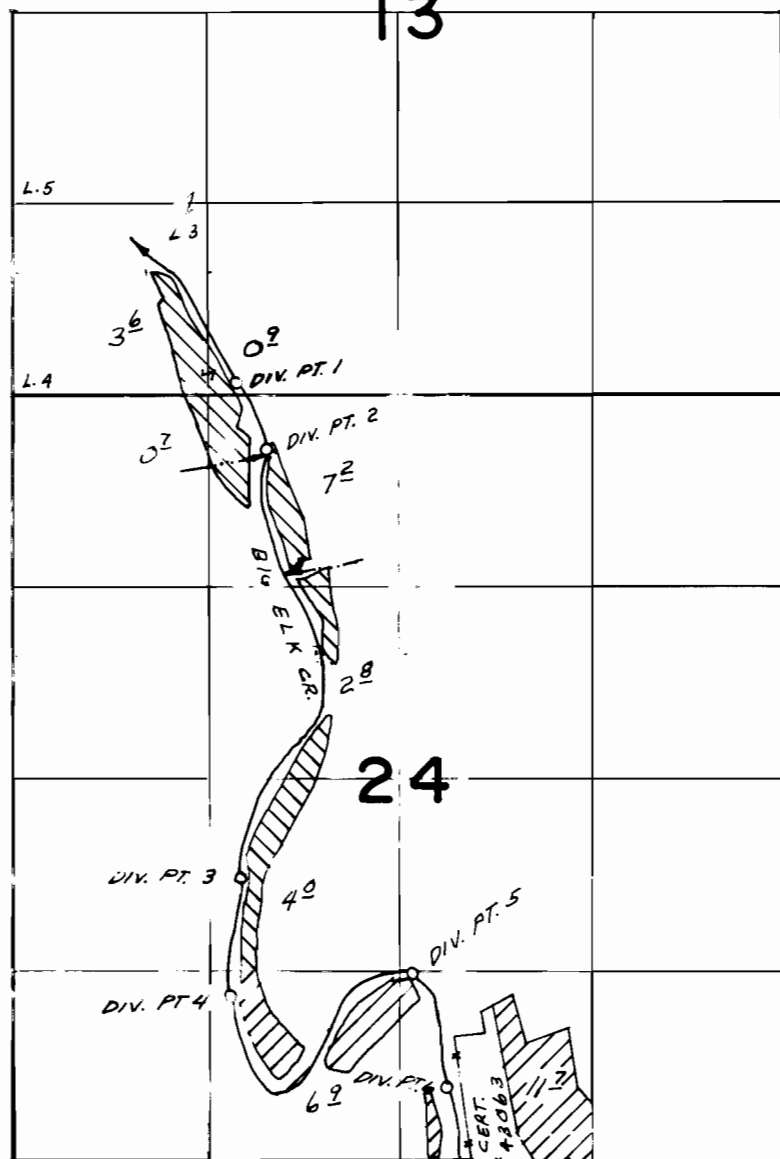

FINAL PROOF SURVEY

UNDER

Application No. 52444 Permit No. 39441

Application No. 52445 Permit No. 39442

IN NAME OF

HAROLD L. PARKS

Surveyed AUG. 12, 1976, by L.H. NUNN.....