


T.10S., R.2W., W.M.

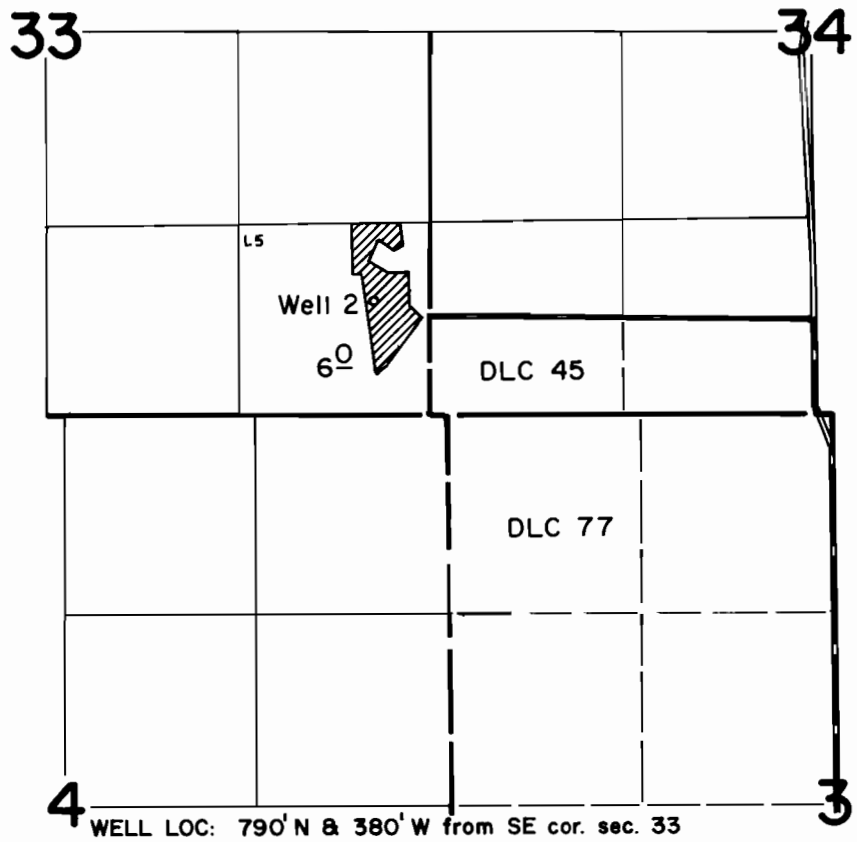

WELL LOC: 790' N & 380' W from SE cor. sec. 33

FINAL PROOF SURVEY
UNDER

Application No. G-3469 Permit No. G-3273
IN NAME OF

JAMES A. BAILEY

Surveyed Sept. 8 1976, by D. Norby