


T.11S., R.2W., W.M.

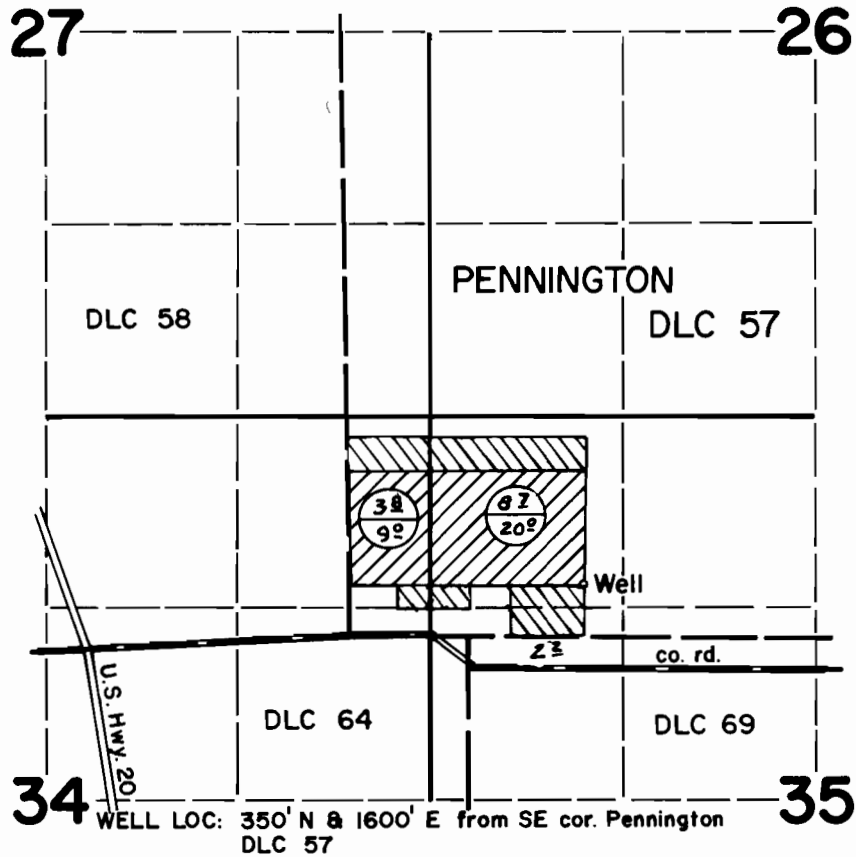

 Permit G-6063
Certificate 32203

FINAL PROOF SURVEY UNDER

Application No. G-6468 Permit No. G-6063
IN NAME OF

ROBERT F. & ISABEL R. MEYER

Surveyed April 16 1976, by D. Norby