


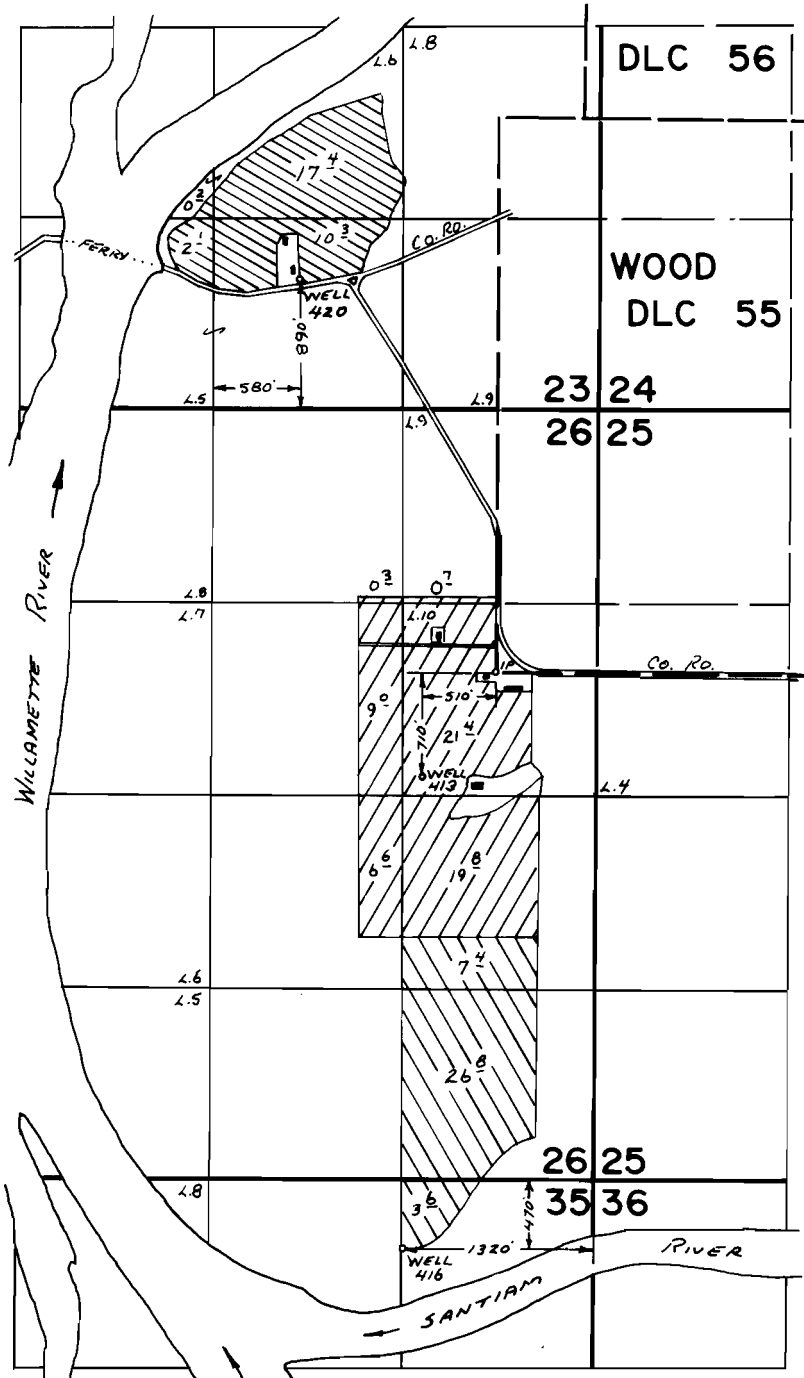

T.9S.,R.4W.,W.M.



FINAL PROOF SURVEY UNDER

Application No. G-5668 Permit No. G-5492  WELL 413  WELL 416
 Application No. G-5669 Permit No. G-5491
 IN NAME OF

MARI-LINN FARMS, INC.

Surveyed Oct. 6, 1976, by L. Toll