


T.6S.,R.2W.,W.M.

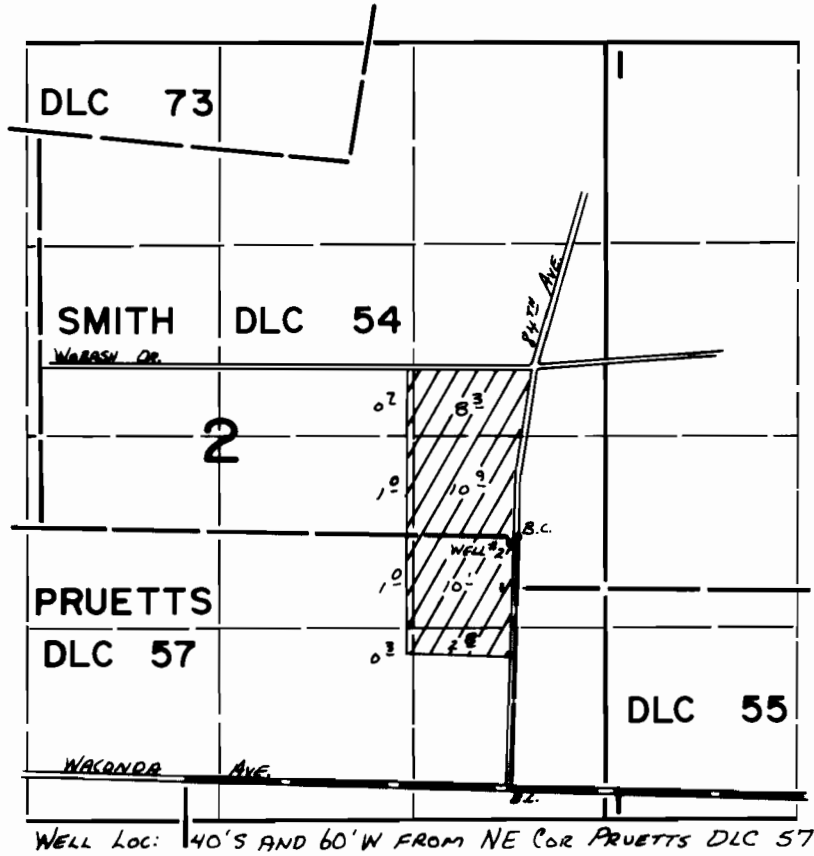

**FINAL PROOF SURVEY**  
UNDER

Application No. G-5797. Permit No. G-5562.  
IN NAME OF

**KARNILY & AGAFIA KALUGIN.**

Surveyed JUNE 3, 1976, by L. TOLL