


T.6S.,R.1W.,W.M.

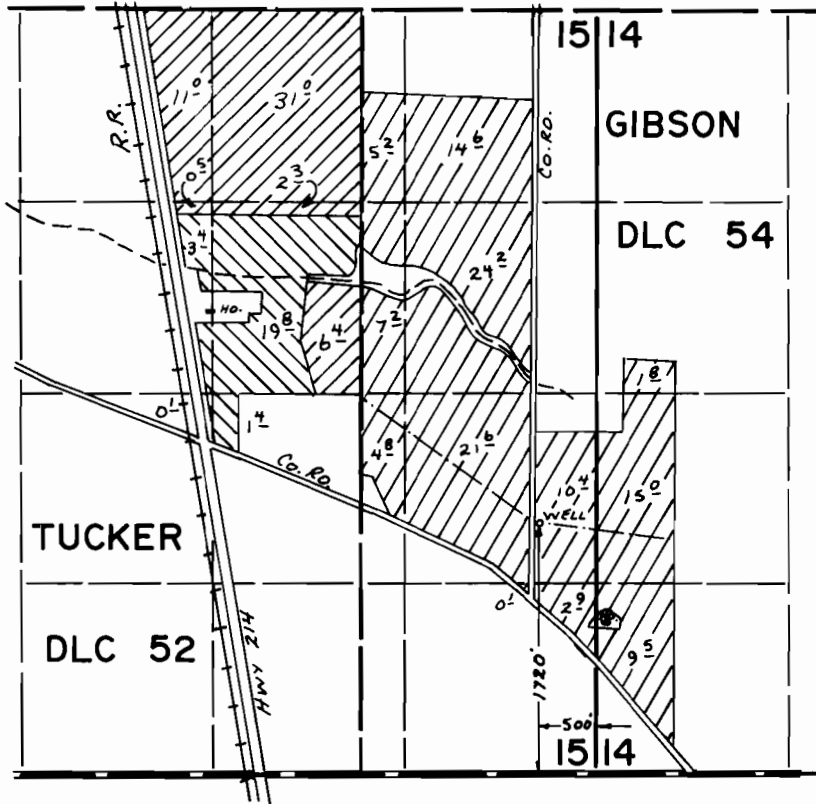

FINAL PROOF SURVEY UNDER

G-5446 G-5362
 Application No. G-7297 Permit No. G-6748
 IN NAME OF

 - PRIMARY  - SUPP'L

CHARLES WAVRA

Surveyed Aug. 10, 1976, by L. Toll