T.4&5S.,R.1W.,W.M.

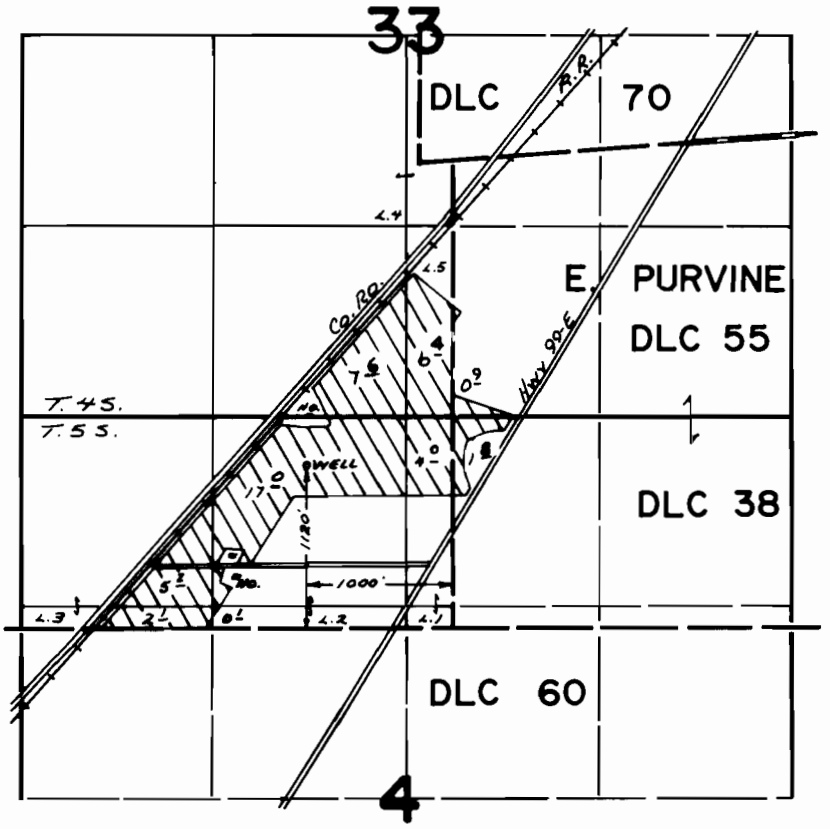

FINAL PROOF SURVEY
UNDER

Application No. G-5935 Permit No. G-5640
IN NAME OF

DONALD BURLINGHAM

Surveyed April 23 1976, by L. Tow

DFN-311-68