


T.3N.,R.2W.,W.M.

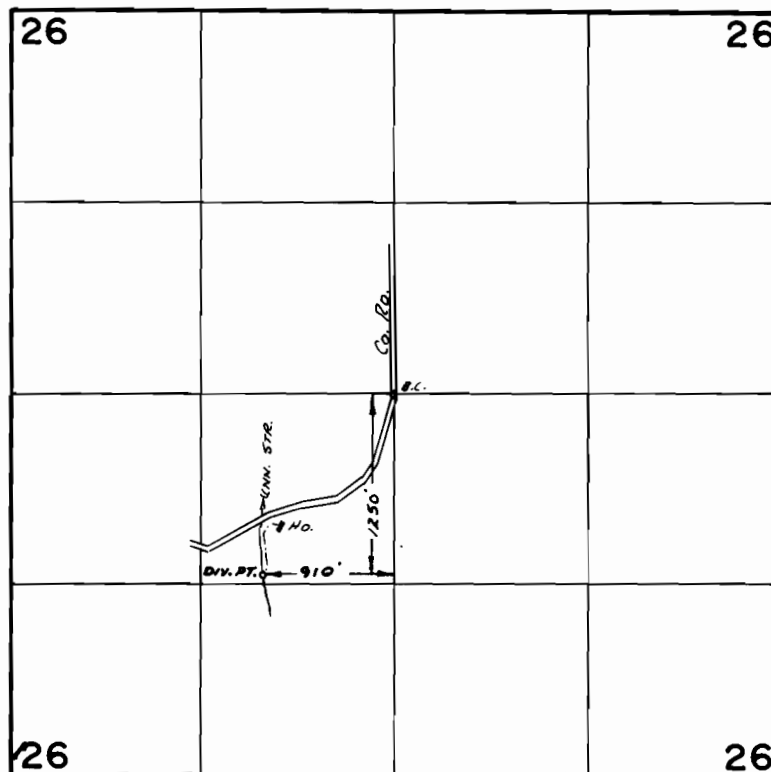

**FINAL PROOF SURVEY**  
UNDER

Application No. 41826 Permit No. 31305  
IN NAME OF

WILLIAM J. GREENE

Surveyed JUNE 7 1976, by L. T. G.