


T.3N.,R.2W.,W.M.

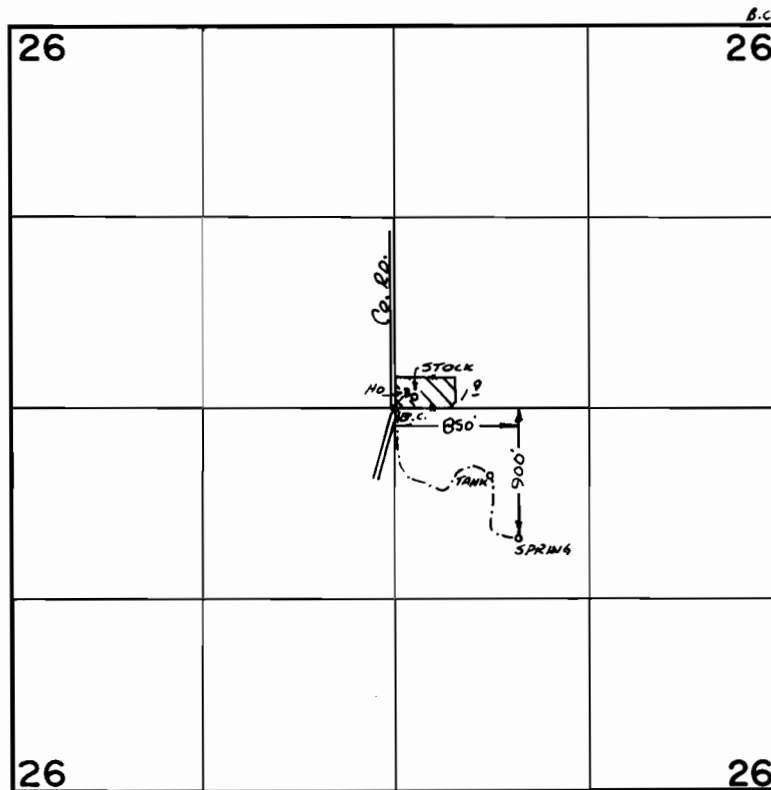

FINAL PROOF SURVEY
UNDER

37546 27915
Application No. 51865 Permit No. 37402.
IN NAME OF
RICHARD A. &
MARQUETTA L. GEMINIANI

Surveyed JUNE 7 1976, by L. Tow