


G 5334
4700b

T.3N.,R.30&31E.,W.M.

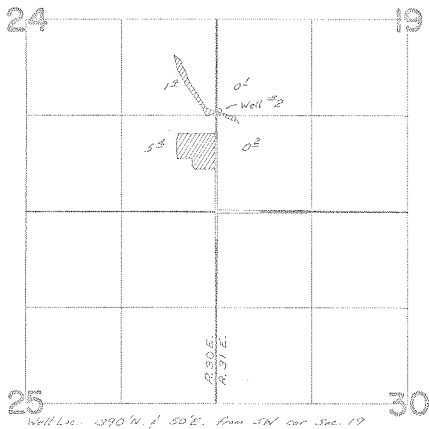

FINAL PROOF SURVEY UNDER

Application No. G-6601 Permit No. G-5334
IN NAME OF

Rew. Ranches, Inc.

Surveyed July 24, 1976 by L. H. Nunn.

PTS-1976-P-111