


T.7 S., R.5. W., W. M

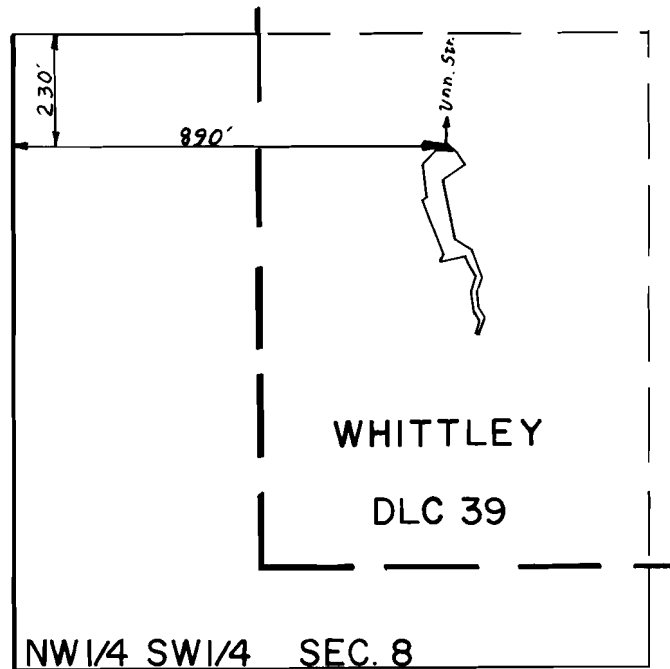

SCALE: 1"=400'

FINAL PROOF SURVEY
UNDER

Application No. 51157 R-51156 Permit No. 38816 R-6227
IN NAME OF

D. T. BARTEL

Surveyed MAY 11 1976, by L.H. NUNN