


T.2N.,R.10W.,W.M.

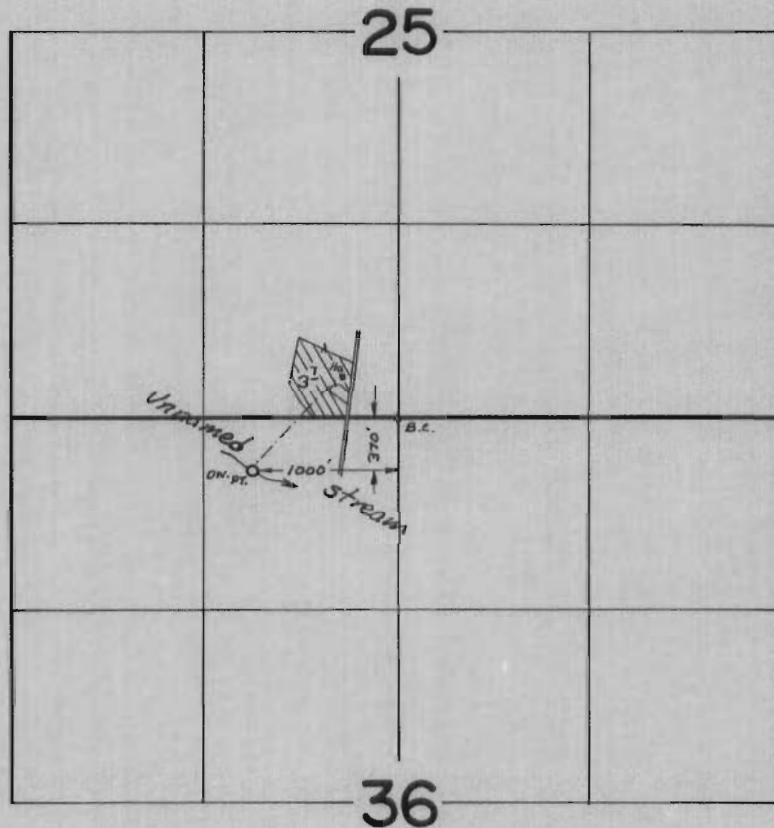

FINAL PROOF SURVEY
UNDER

Application No. 47688 Permit No. 35678
IN NAME OF

DENNIS AVERY VERMILYEA

Surveyed JUNE 27 1974, by D. NORBY