


T. 1 S. R. 8 W. W. M.

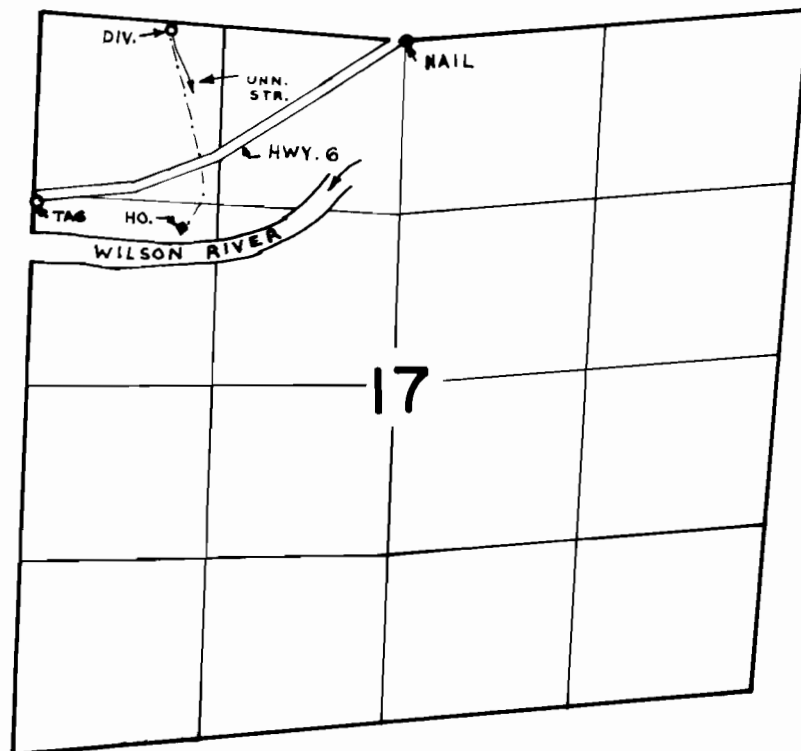

P.O.D. : 1130' N. & 930' E. FROM S.W. COR. N.W. 1/4 N.W. 1/4

FINAL PROOF SURVEY UNDER

Application No. 47959 Permit No. 35909
IN NAME OF

PEARL HUGHEY SISKEY

Surveyed July 28, 1976, by R.G. Mucken