


# T.2S.,R.9W.,W.M.

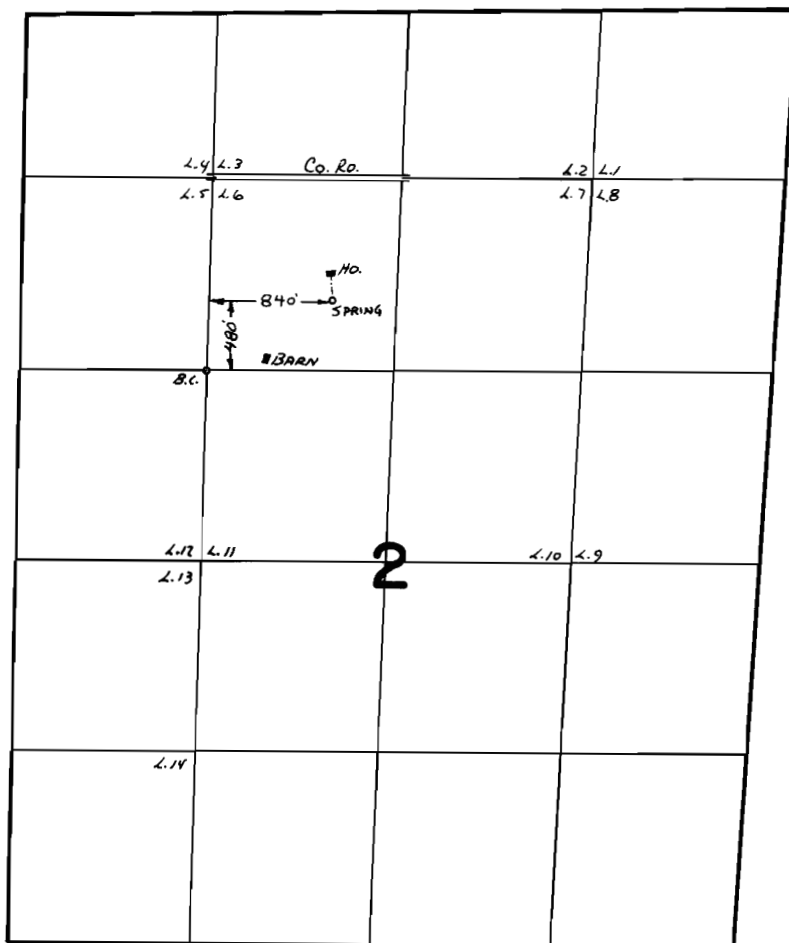

## FINAL PROOF SURVEY UNDER

Application No. 50659 Permit No. 37138  
IN NAME OF

KENNETH ALFRED BUSS

Surveyed July 1, 1976, by L. T. ...