


G 5785
47019

T.3N.,R.33E.,W.M.

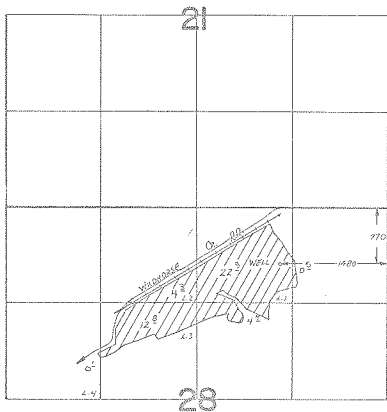

FINAL PROOF SURVEY
UNDER

Application No. ..G:6110.. Permit No. ..G:5785.
IN NAME OF

SMITH-DUEF.....RANCHES,.....INC...

Surveyed *Approx.* 13. 1976, by *L. T. Galt*.....