


T.1 S., R.38 E., W.M.

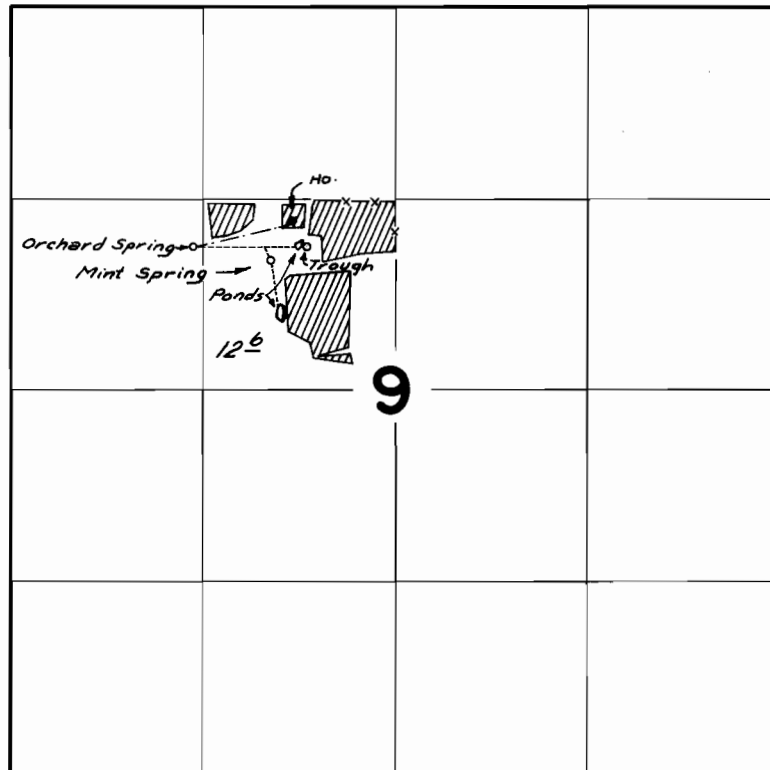

Orchard Spring Loc.: 1650 ft S. & 1250 ft E.: both from
Mint Spring Loc.: 1740 ft S. & 1780 ft E.:
NW. Corner Section 9.

FINAL PROOF SURVEY
UNDER

Application No. 49277 Permit No. 36931
IN NAME OF

Louis H. & Rita L. Sparks

Surveyed Oct 27, 1976, by L. H. Nunn