


T. 1 N., R. 39 E., W.M.

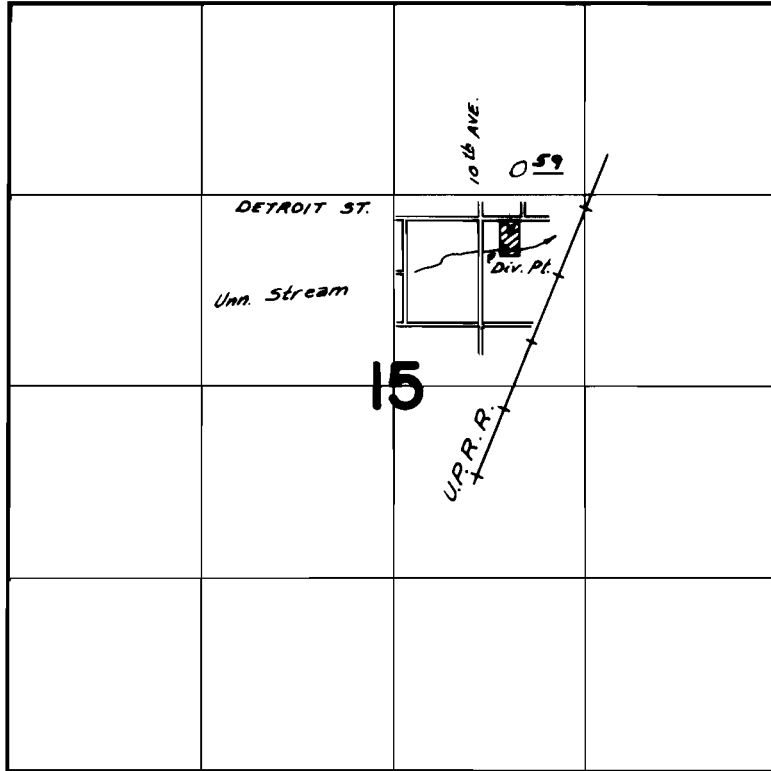

Div. Pt. Loc.: 960 A N. & 760 A E. from ctr. $\frac{1}{4}$
cor. Sec. 15.

FINAL PROOF SURVEY UNDER

Application No. 52217 Permit No. 39312
IN NAME OF

Donald Ray Hendricks

Surveyed Oct 25, 1976 by L.H. Nunn