

Application No. 52485


Permit No. 39625

RECEIVED

OCT 4 1974

STATE ENGINEER
SALEM, OREGON

T.1S. R.38E. W.M.

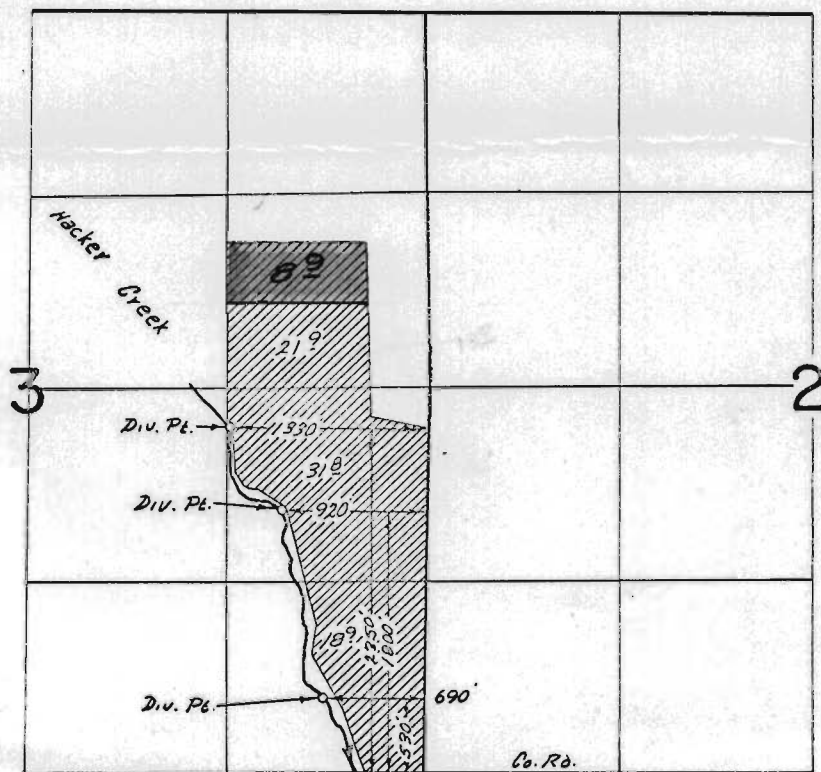

FINAL PROOF SURVEY
UNDER

NEW LAND

Application No. 42322 Permit No. 31641
IN NAME OF

HAZEL N. CLARK & ESTATE OF CARL C. CLARK

Surveyed July 13, 1973, by R.G. Mucken

H-N-C