


T.2S.R.44E.W.M.

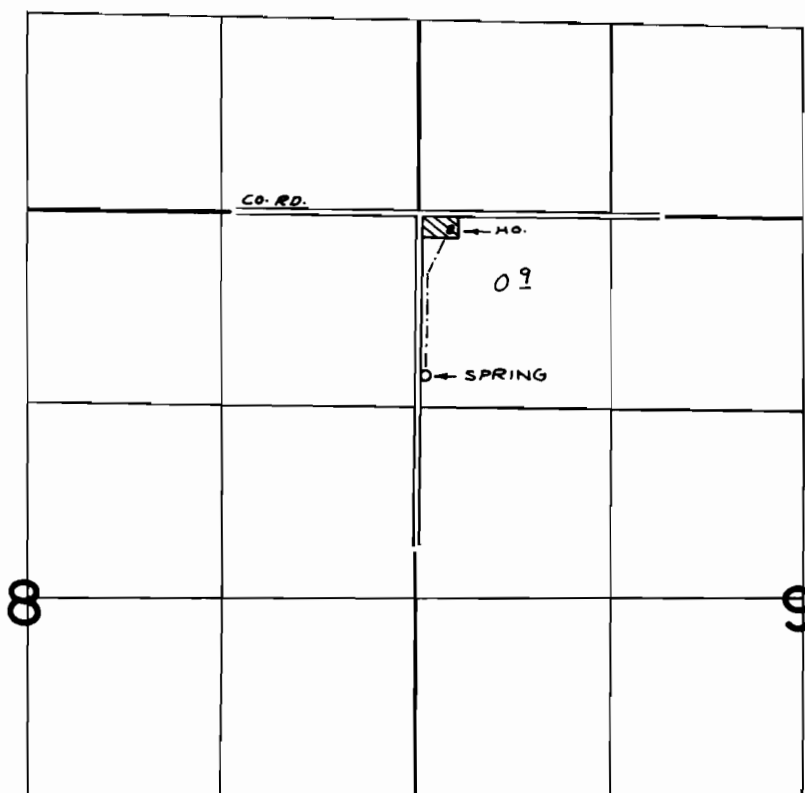

SPRING LOC: 1120'S. & 50'E. FROM N.W. COR. SEC. 9

FINAL PROOF SURVEY
UNDER

Application No. 50773 Permit No. 38343
IN NAME OF

ELSIE J. PHILLIPS

Surveyed SEPT. 22, 1976, by R. MUCKEN