


T. 2 S. R. 44 E. W. M.

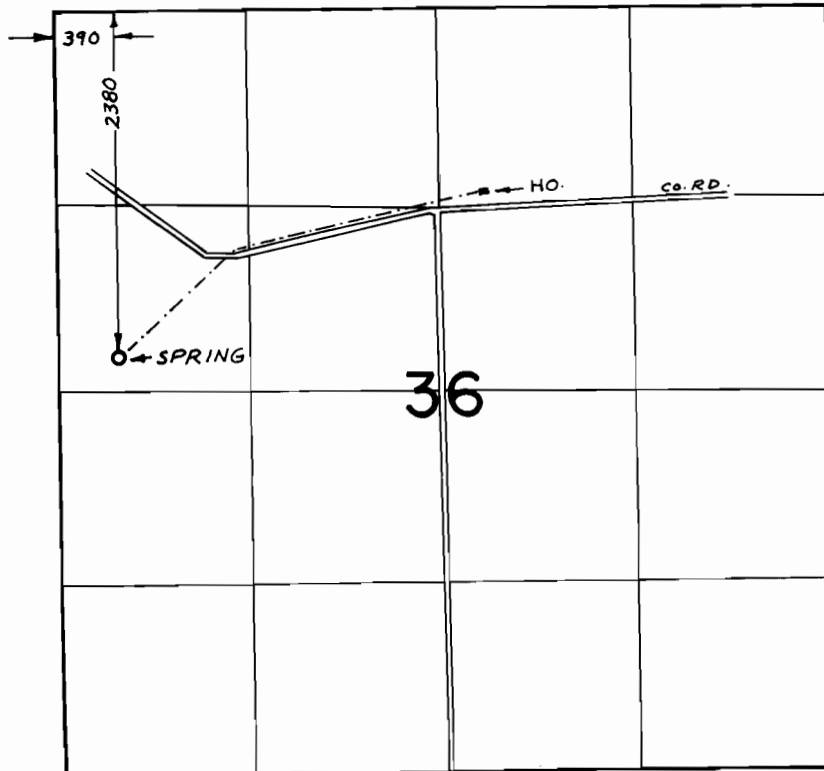

FINAL PROOF SURVEY
UNDER

Application No. 53093 Permit No. 39581
IN NAME OF

SYLVIA I. BONER

Surveyed SEPT. 23 1976, by R. MUCKEN