


T. 1 N., R. 4 W. W.M.

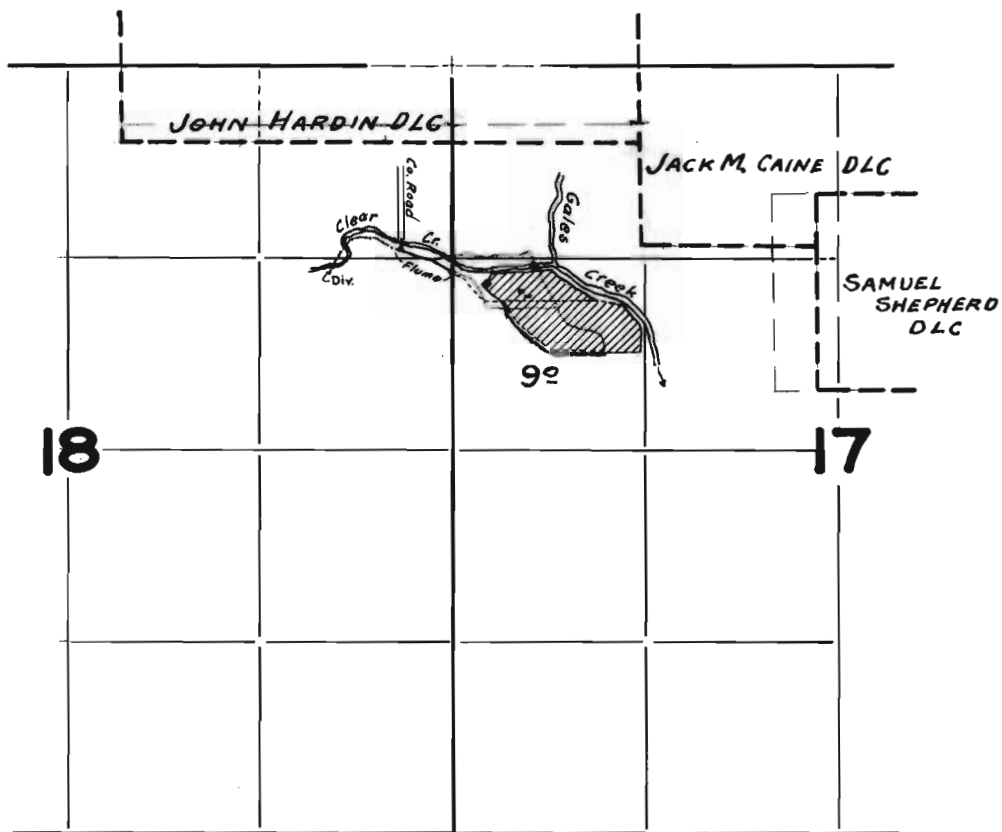

FINAL PROOF SURVEY UNDER

Application No. 16067 Permit No. 12035

IN NAME OF

Eli W. Howell

Surveyed Aug. 8, 1942, by Geol. Pederman