


P-40024
47635

T.7S., R.21E., W.M.

1" = 330'

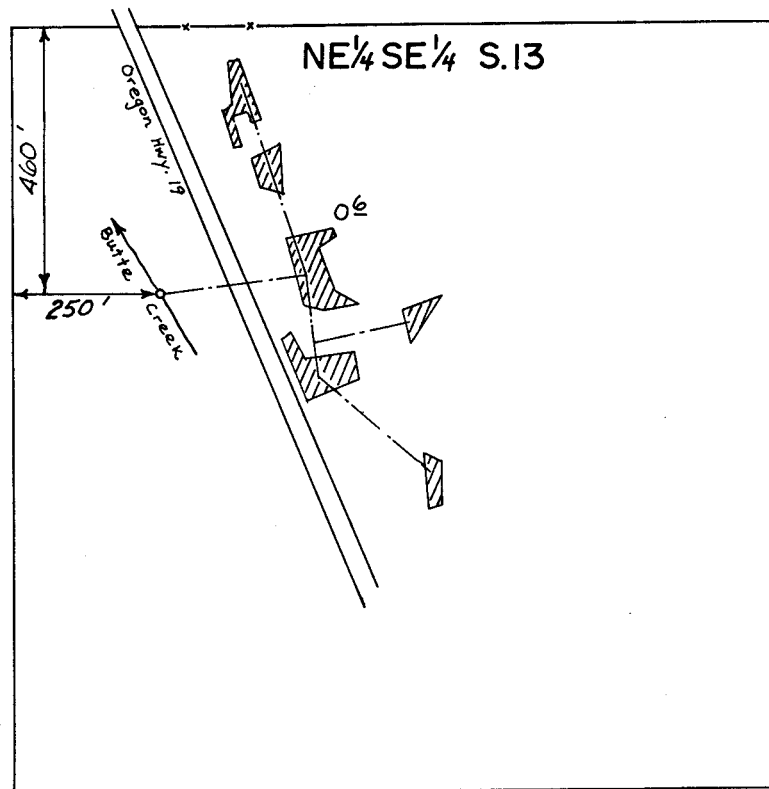

FINAL PROOF SURVEY
UNDER

Application No. 53035 Permit No. 40024
IN NAME OF

OREGON STATE FORESTRY DEPT.

Surveyed AUG. 25, 1976, by D. NORBY

PTS 1976-C