


T.4 S., R.6 W., W.M.

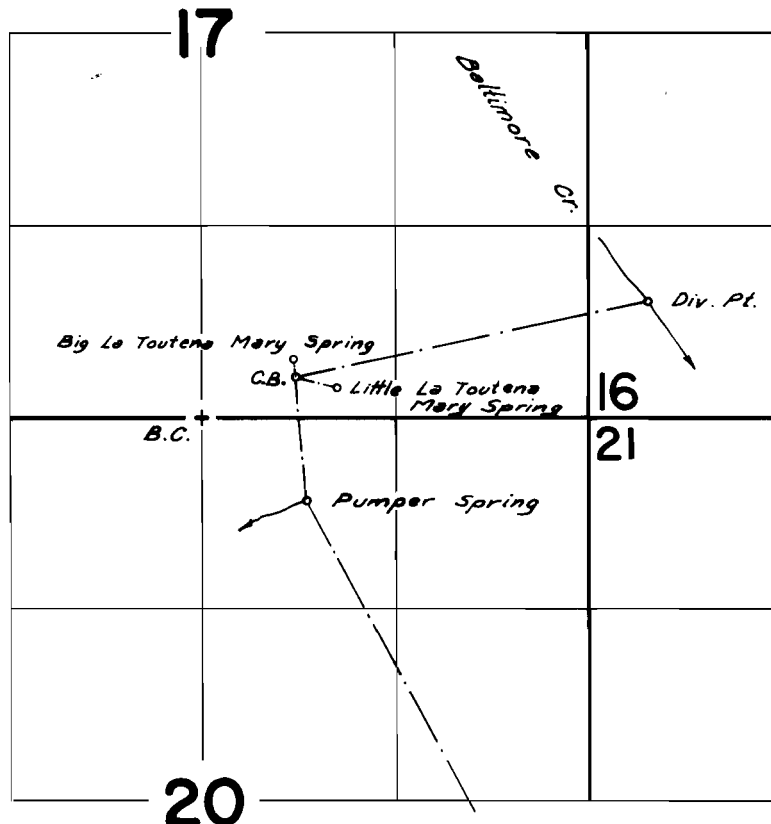

Pumper Spr. Loc.: 570' S. & 720' E. from S $\frac{1}{4}$ Cor. Sec. 17
Div. Pt. Loc.: 800' N. & 400' E. from SW Cor. Sec. 16

FINAL PROOF SURVEY
UNDER

Application No. 13547 Permit No. 9701
IN NAME OF

City of Sheridan

Surveyed July 9, 1976, by L.H. Nunn

PTS-1976-P *ALB*