


T. 4 S., R. 6 W., W.M.

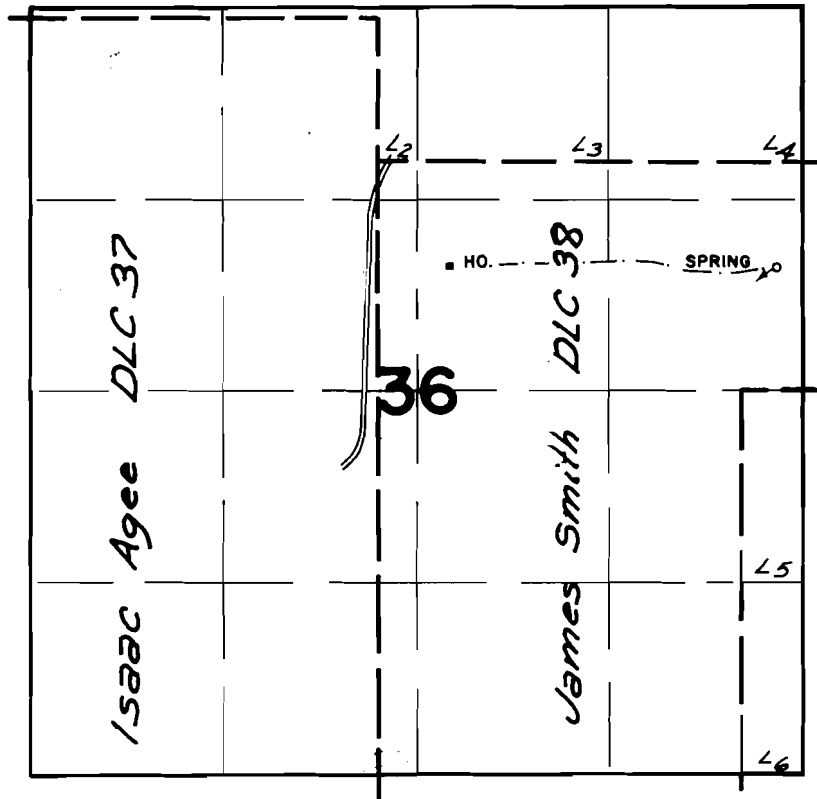

Spring Loc.: 850 A.N., & 2460 A.E. from Ctr. $\frac{1}{4}$ Sec 36

FINAL PROOF SURVEY
UNDER

Application No. 45008 Permit No. 33633
IN NAME OF

E. Howard Nielsen

Surveyed July 8, 1976 by L. H. Nunn