T. 4 S., R. 4 W., W.M.

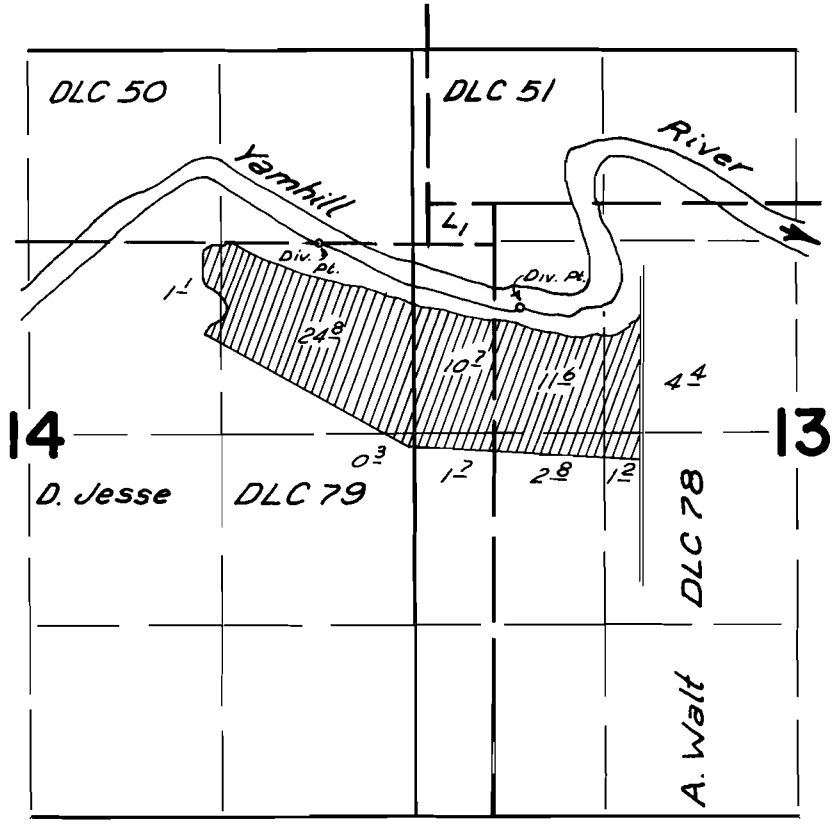

Div. Pts. Loc.: #1 - 1300 ft N. & 620 ft W.; #2 - 840 ft N., & 760 ft E., both from E. 1/4 Cor. Sec. 14

FINAL PROOF SURVEY
UNDER

Application No. 48217 Permit No. 36210
IN NAME OF

Norman Reid

Surveyed Mar. 31, 1976, by L. H. Nunn

DFG-ILL-159