


# T.5S., R.5W., W.M.

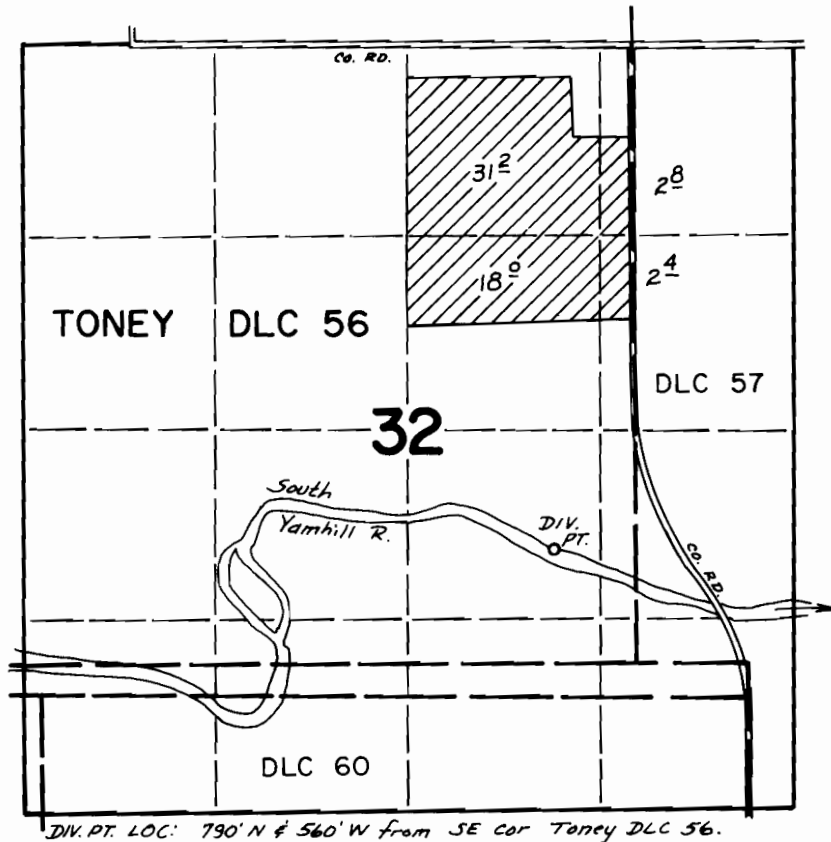

## FINAL PROOF SURVEY UNDER

Application No. 51359 Permit No. 38841  
IN NAME OF

NORMAN A. & SHIRLEY M. SEMENZA

Surveyed July 7 1976, by L.H. Nunn