


T.5S., R.6W., W.M.

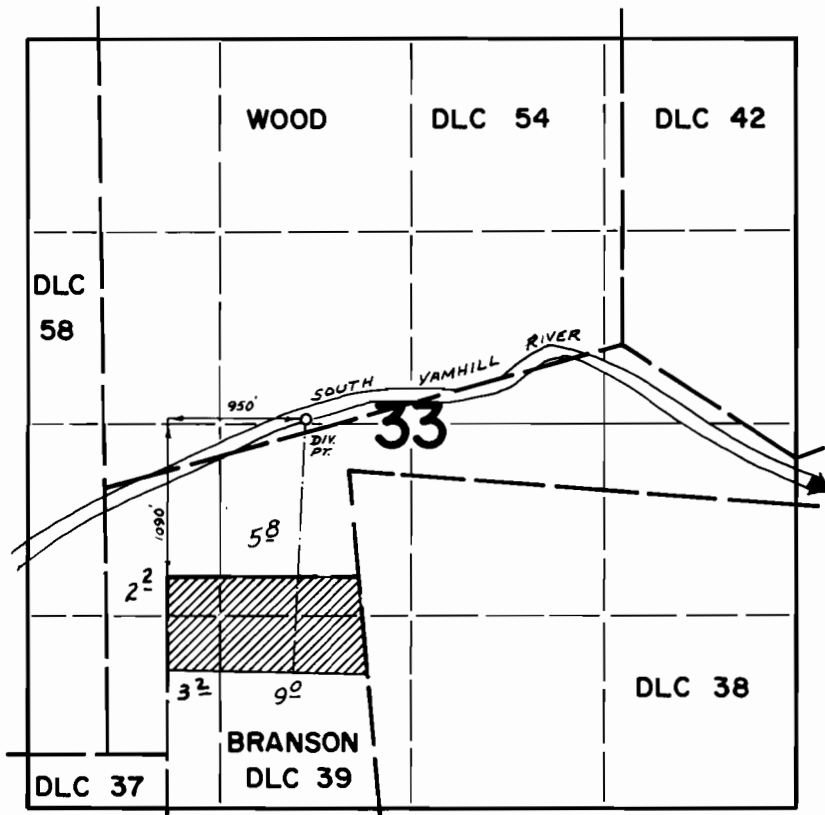

FINAL PROOF SURVEY UNDER

Application No. 52172 Permit No. 39286
IN NAME OF

WILLIAM AND FRANCINE DRABKIN

Surveyed July 8 1976, by L.H. Nunn