


T.5S.,R.6W.,W.M.

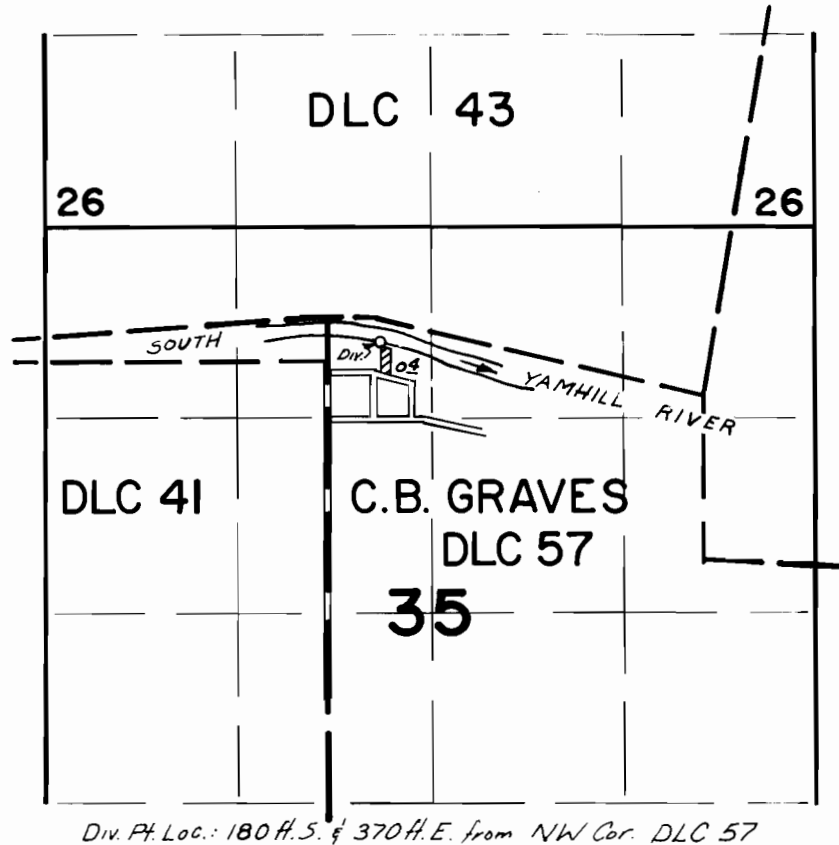

FINAL PROOF SURVEY UNDER

Application No. 52975 Permit No. 39992
IN NAME OF
RICHARD & SHARON DORAN

Surveyed AUG 4, 1976, by D. NORBY