


T.7&8N. R.4&5W. W.M.

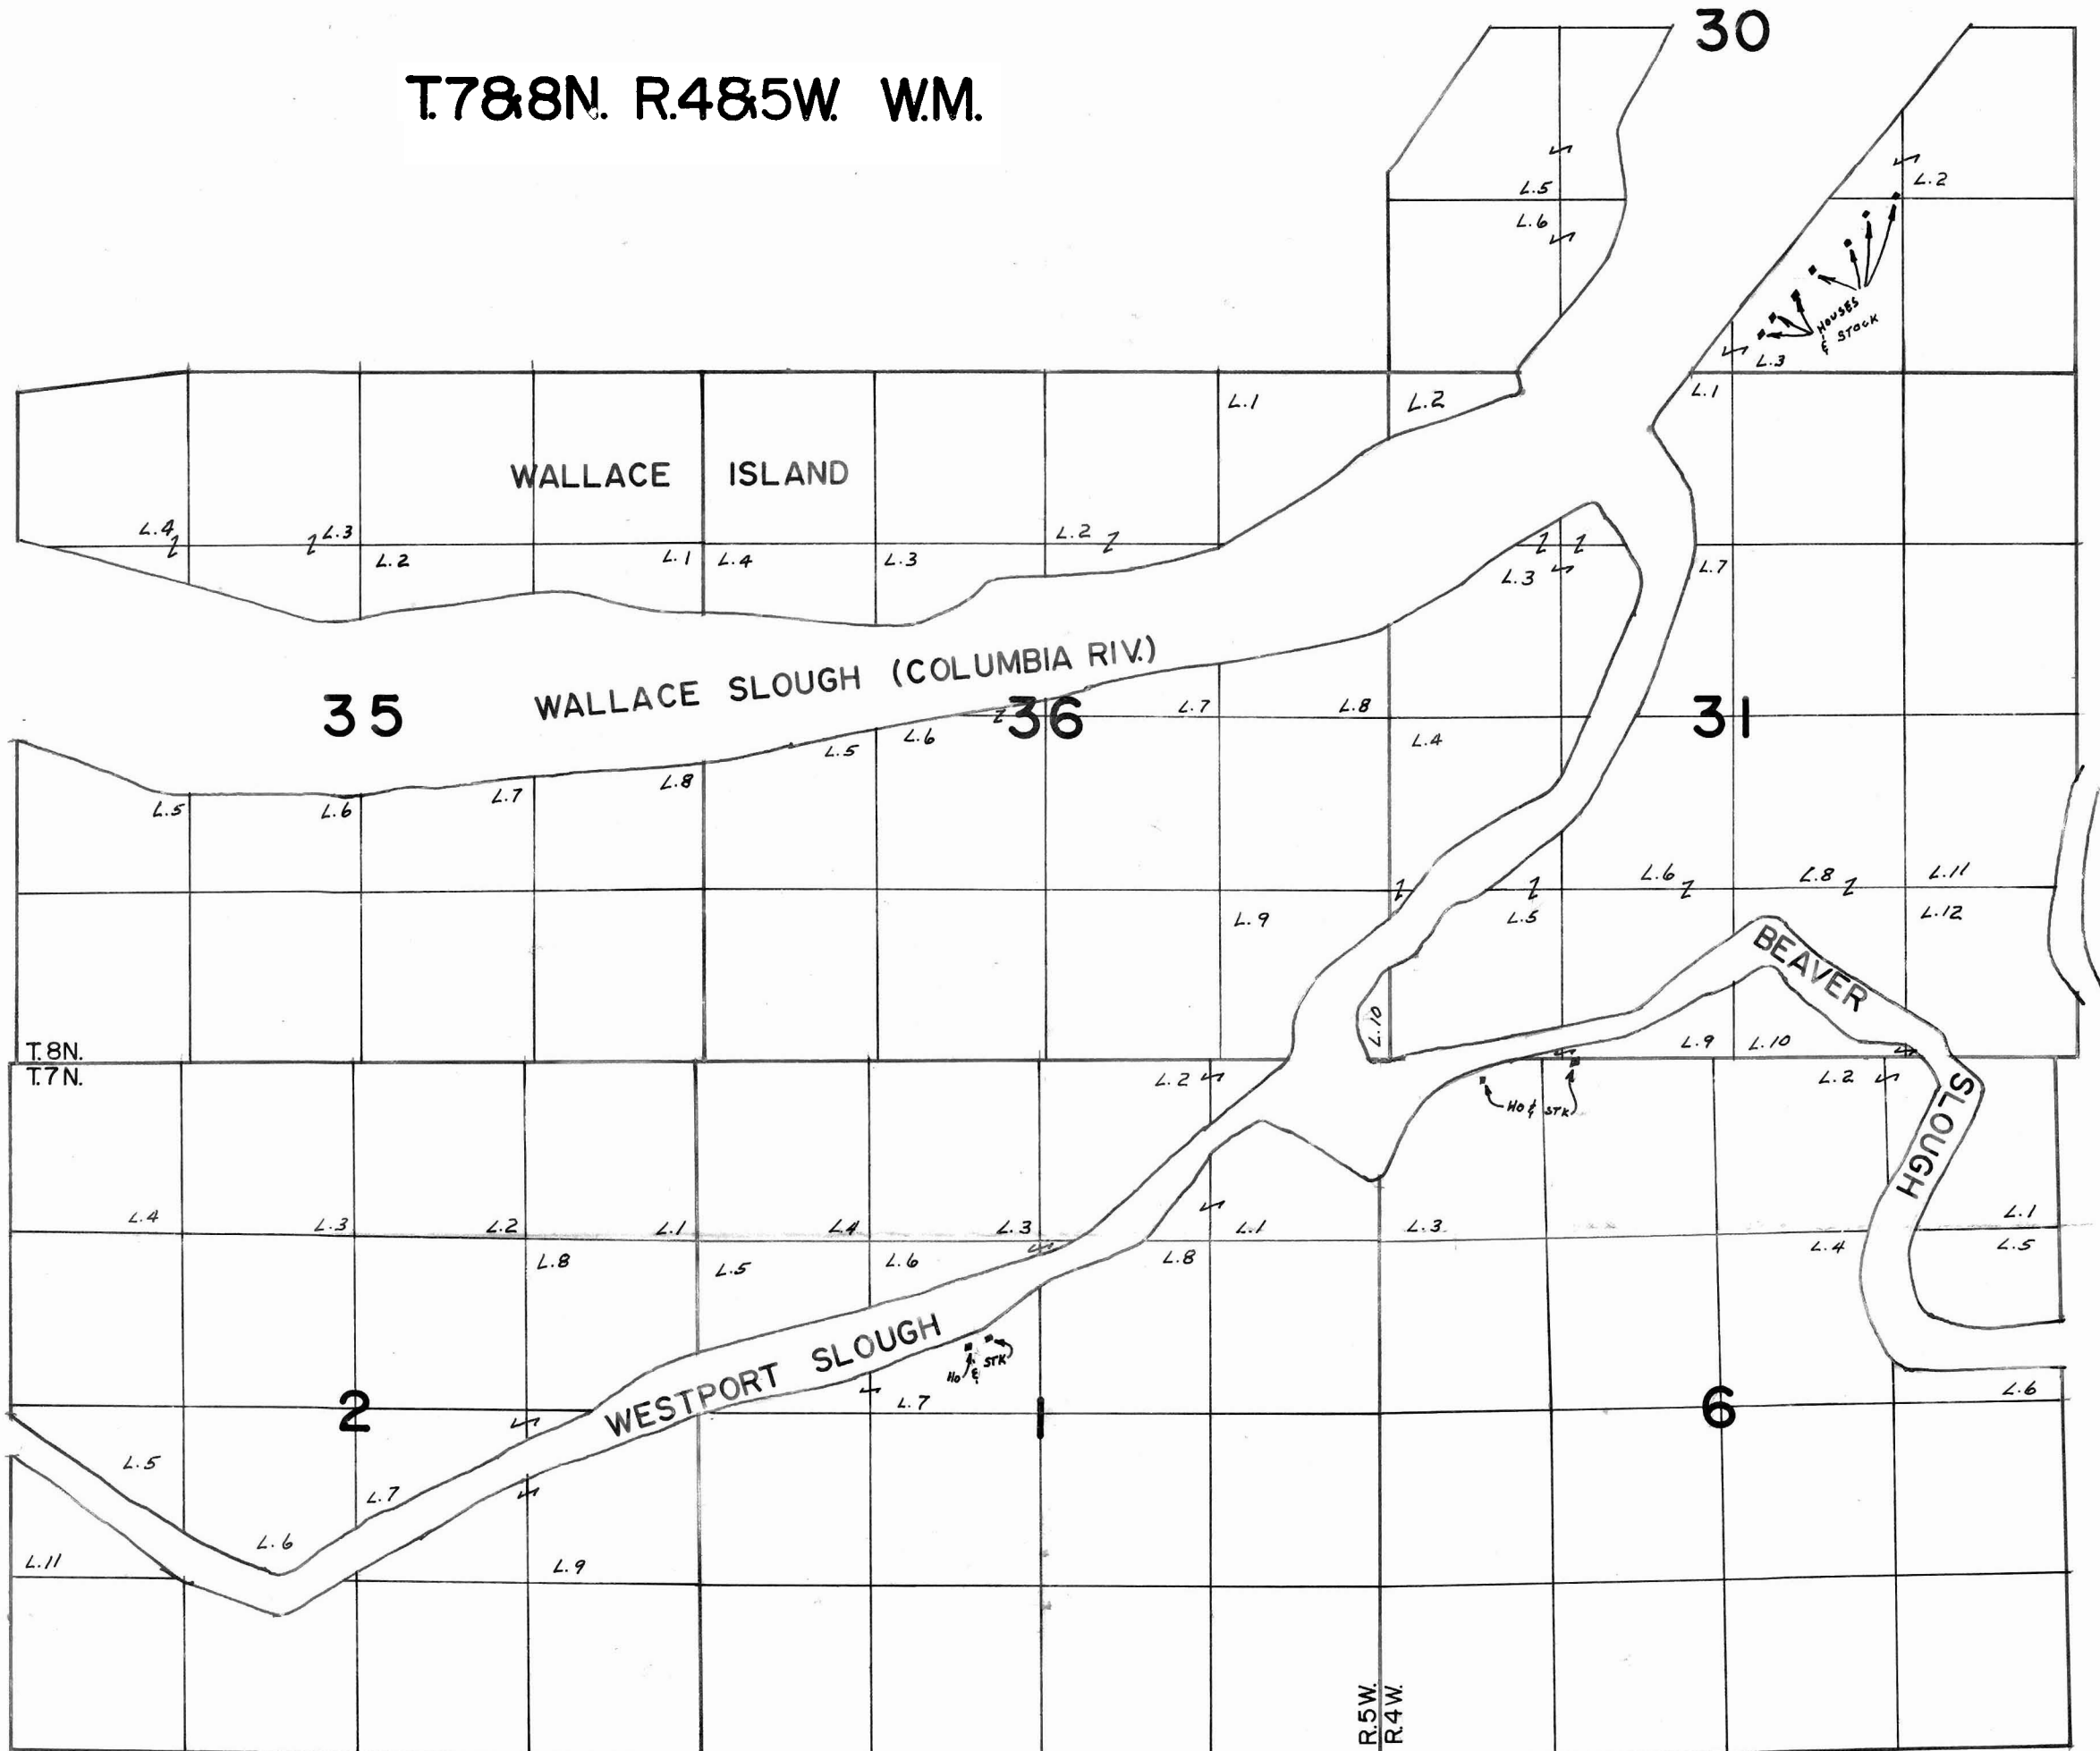

LAYOUT FROM G.L.O. PLATS

DIVERSION POINT  
SURVEYED AUG. 6, 1950  
BY H.L. COFFMAN  
1950-F

## FINAL PROOF SURVEY UNDER

Application No. 40817 Permit No. 30432  
IN NAME OF

MIDLAND WATER ASSOCIATION

SURVEYED JULY 2, 1976 BY L.H. NUNN

1976-P