


T.30S., R.3W., W.M.

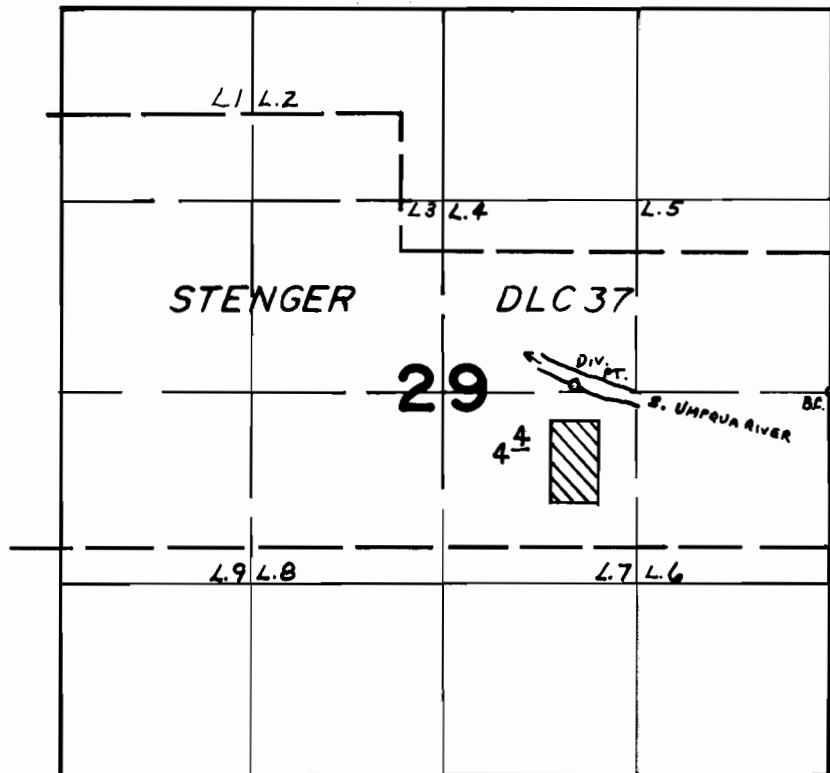

DIV. PT. LOC. 50 N. $\frac{1}{2}$ 1750 W. FROM E. $\frac{1}{4}$ COR. SEC. 29

FINAL PROOF SURVEY UNDER

Application No. 48479. Permit No. 37353...
IN NAME OF

Joseph C. Ash

Surveyed May 11, 1977, by D.M. NORBY.....