


T. 38 S., R. 8 W., W.M.

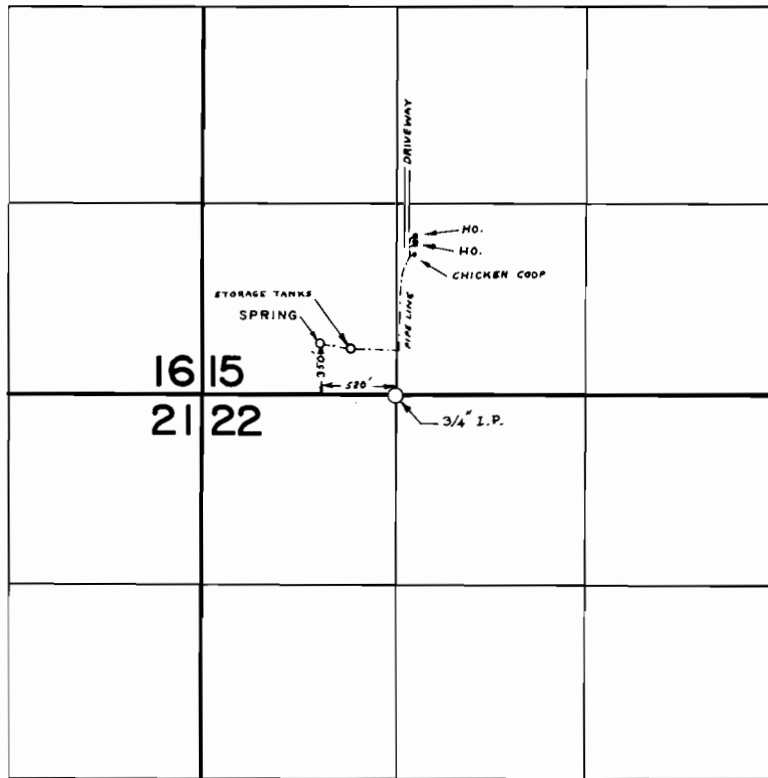

**FINAL PROOF SURVEY**  
UNDER

Application No. 48833 Permit No. 36598  
IN NAME OF

VINCENT D. BEAN

Surveyed NOV. 10. 1977, by B. SUND