


T. 39S., R. 5W., W.M.

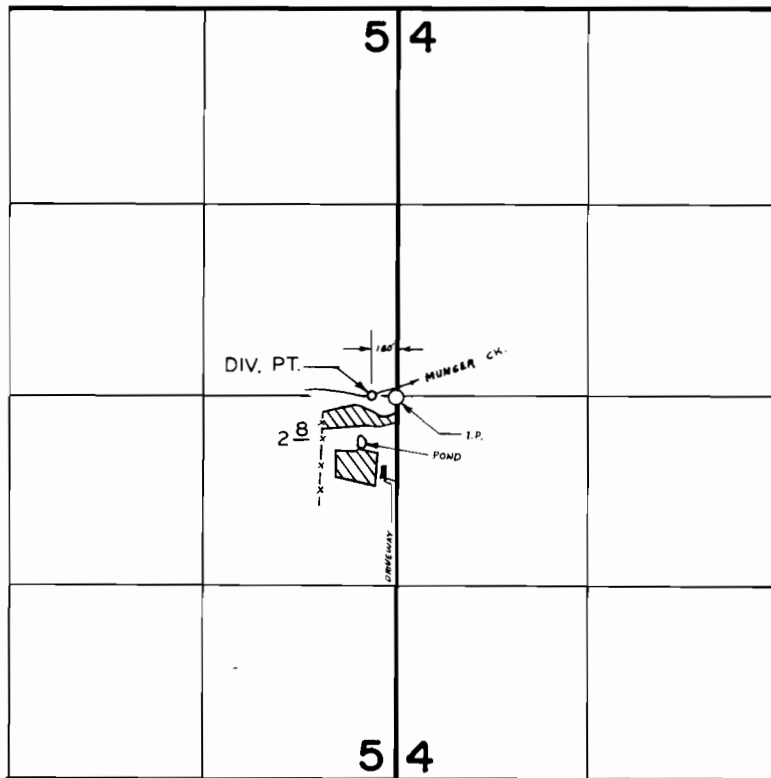

FINAL PROOF SURVEY
UNDER

Application No. 54843... Permit No. 41140....
IN NAME OF

.....DUANE R. REAGAN.....

Surveyed OCT. 19 1977, by B. SUND.....