


T.IIS. R.IOW. W.M.

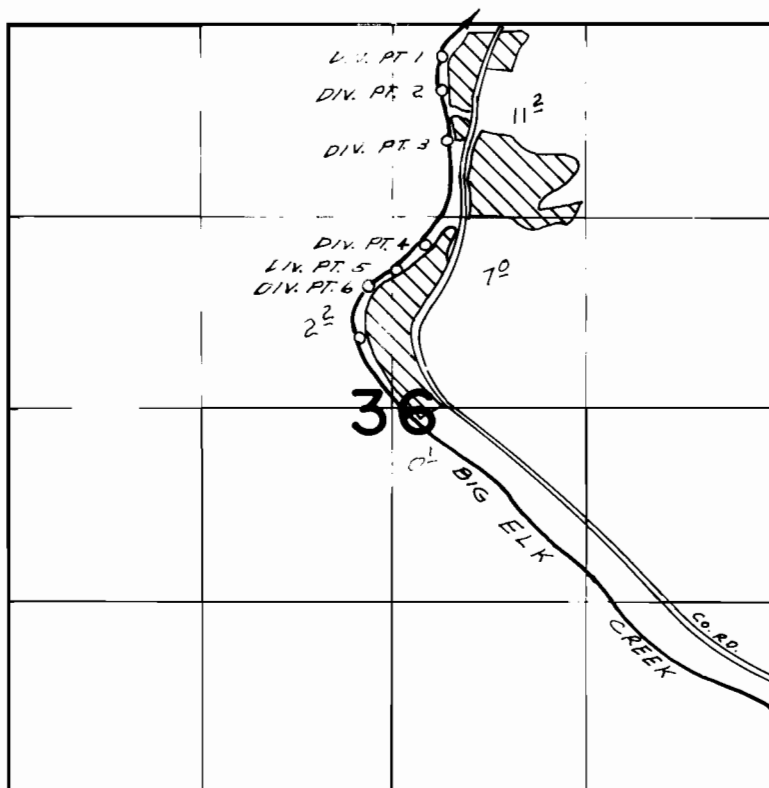

DIV. PTS. LOC. 1- 210'S. & 2300'W., 2- 440'S. & 2300'W.,
3- 800'S. & 2270'W., 4- 1510'S. & 2420'W., 5- 1790'S.
& 2810'W., 6- 2140'S. & 2870'W., ALL FROM NECOR. SEC. 36

FINAL PROOF SURVEY UNDER

Application No. 43176 Permit No. 32274
IN NAME OF

ROBERT J. TANCREDI

Surveyed AUG. 12, 1976, by L.H. NUNN