


T.9S., R.10W., W.M.

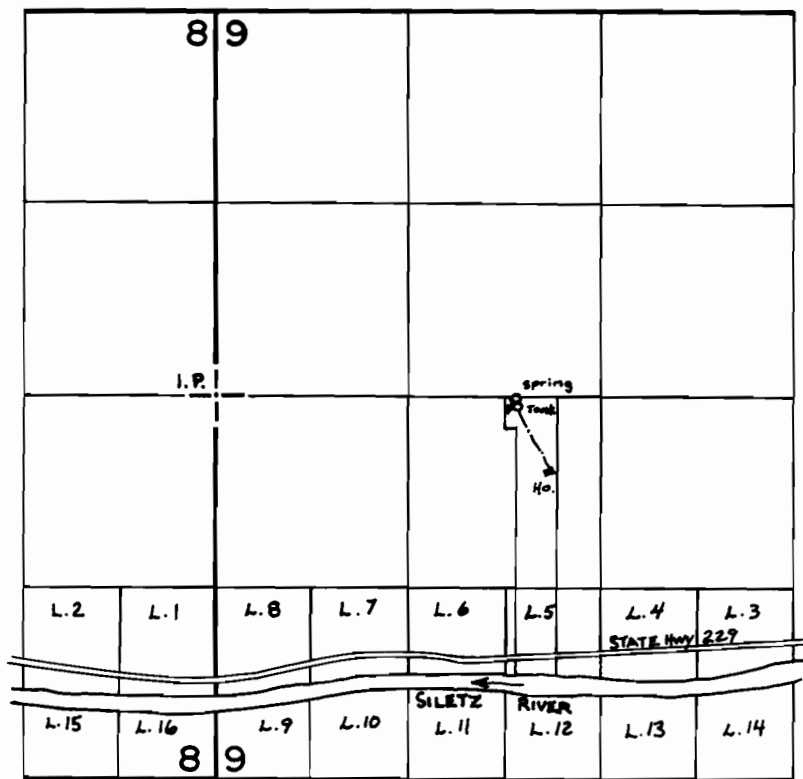

Spring Located 10' S & 575' W from the C 1/4 cor. Sec. 9

FINAL PROOF SURVEY
UNDER

Application No. 52380 Permit No. 39406
IN NAME OF

FRANK W. SIJOTA

Surveyed OCT. 26 1977, by J.S. DONALDSON