


T.9S., R.3W., W.M.

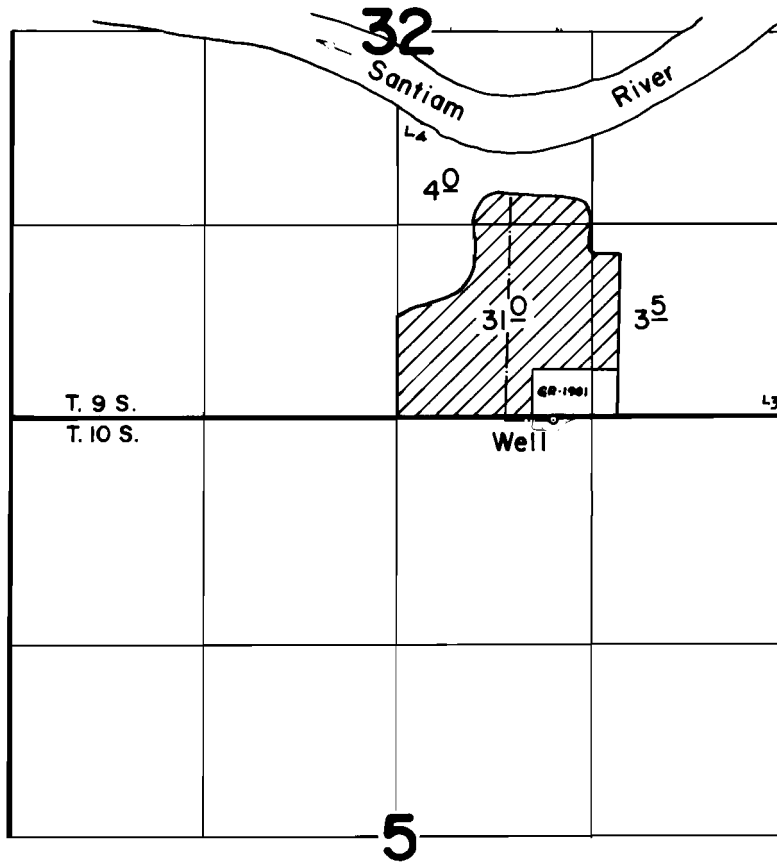

WELL LOC: 1580' W. & 20' S. FROM N.E. COR. SEC. 5

FINAL PROOF SURVEY UNDER

Application No. G-5671 Permit No. G-5493
IN NAME OF

DAVID C. HARNISCH

Surveyed April 12, 1976, by D. Norby