


T.12S. R.1W. W.M.

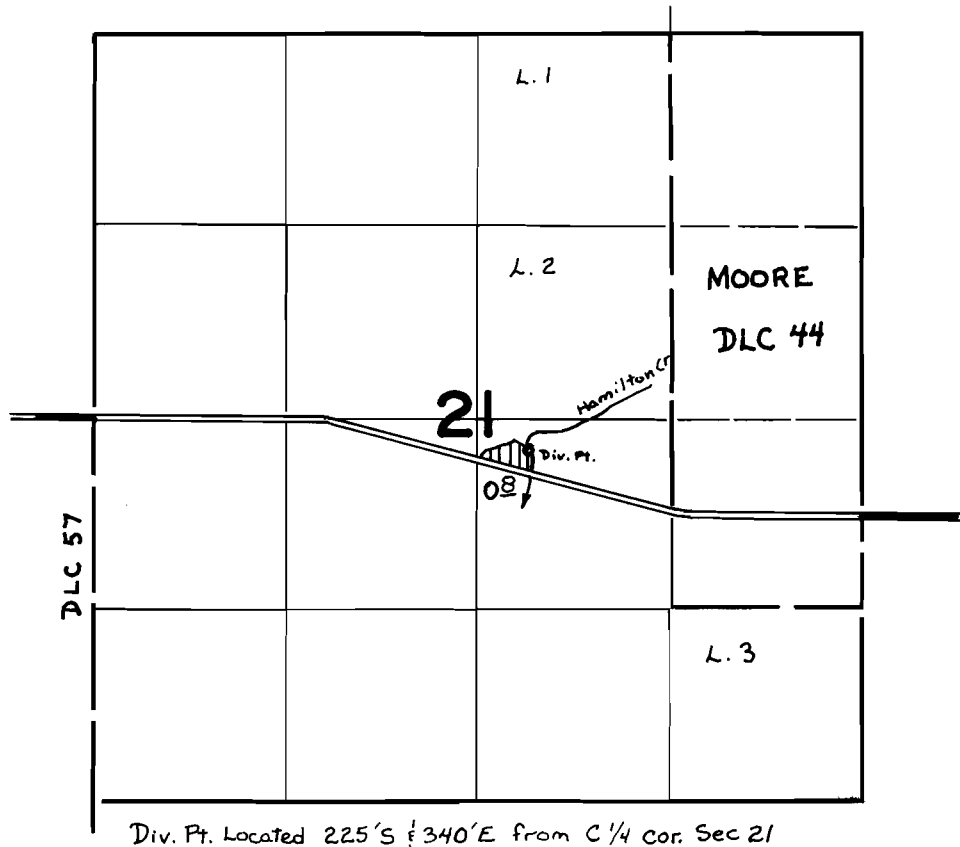

FINAL PROOF SURVEY
UNDER

Application No. 48499 Permit No. 36392
IN NAME OF

DONALD F. HECKERT

Surveyed NOV. 7 1977, by J.S.DONALDSON