




T. 8 S., R. 1 W., W.M.

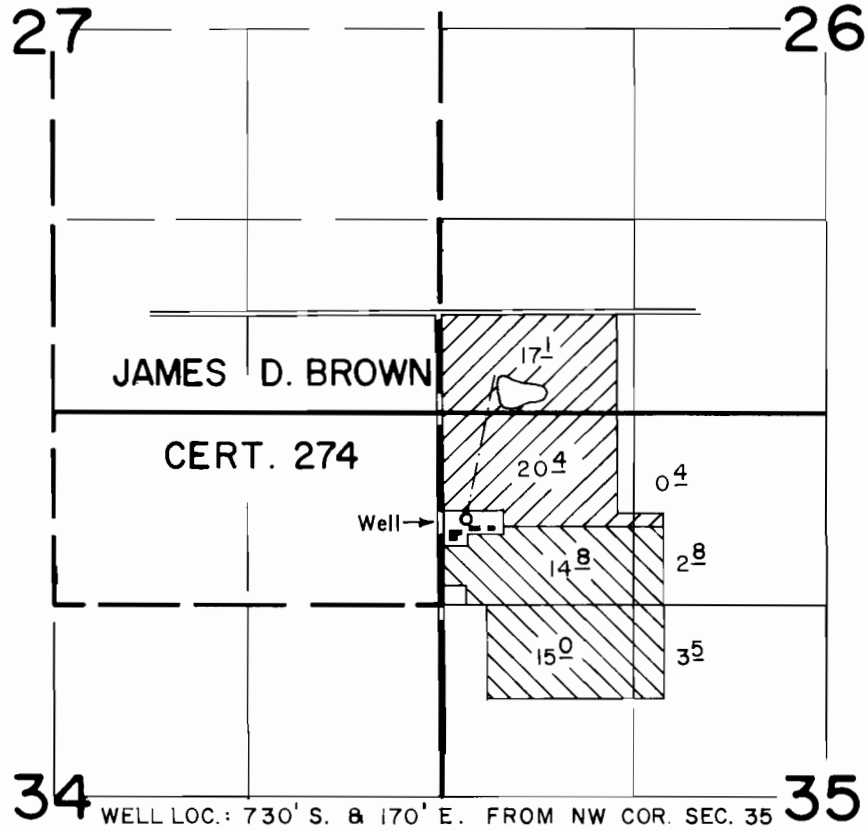

-  PRIMARY
-  SUPP'L. TO GR-2353

FINAL PROOF SURVEY UNDER


Application No. G-4426 Permit No. G-4170

IN NAME OF

ROBERT SCHUMACHER

Surveyed OCT. 26, 1973, by D. NORBY

T.8S.,R.1W.,WM.

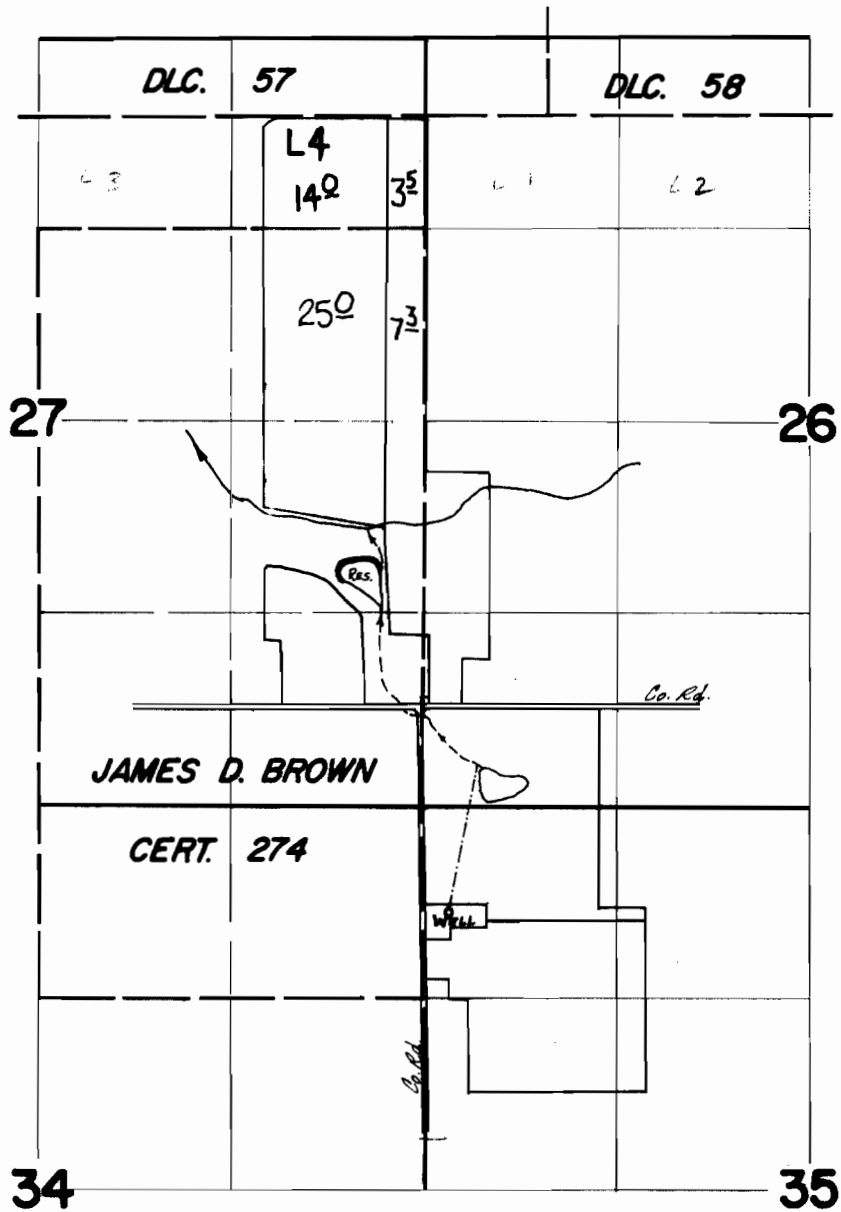

FINAL PROOF SURVEY
UNDER

Application No. G-4426 Permit No. G-4170
IN NAME OF

ROBERT SCHUMACHER

Surveyed Oct. 26 1973, by D. Norway