


T.7S.,R.2W.,W.M.

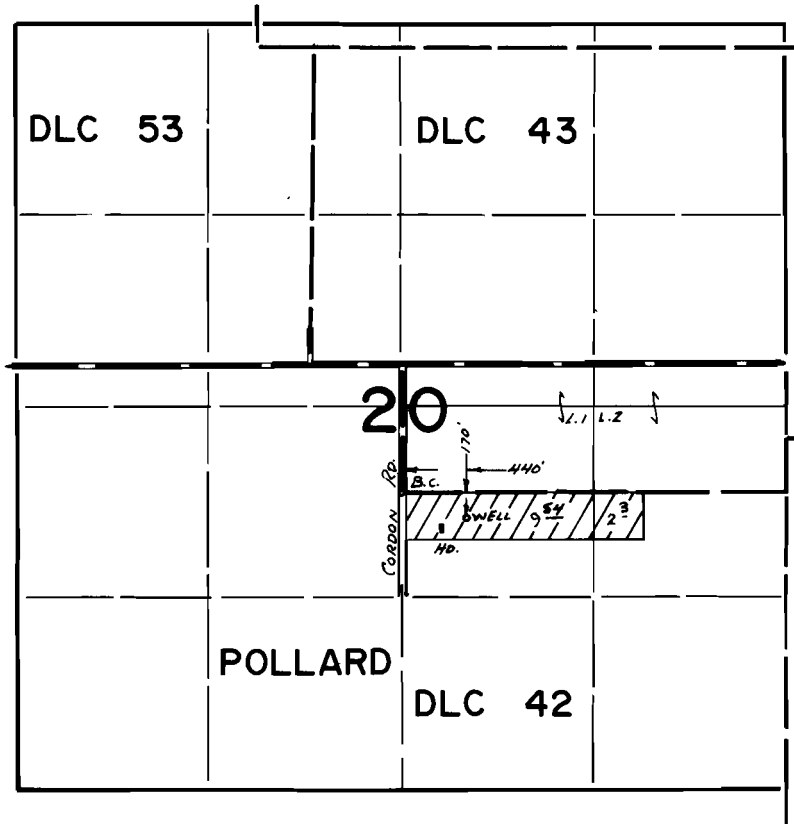

**FINAL PROOF SURVEY**  
UNDER

Application No. G-5665 Permit No. G-5490  
IN NAME OF

.....WALTERS.....A.....WULFERS.....

Surveyed MAY 20 1976, by L. Toll.....