


T.6S.,R.1W.,W.M.

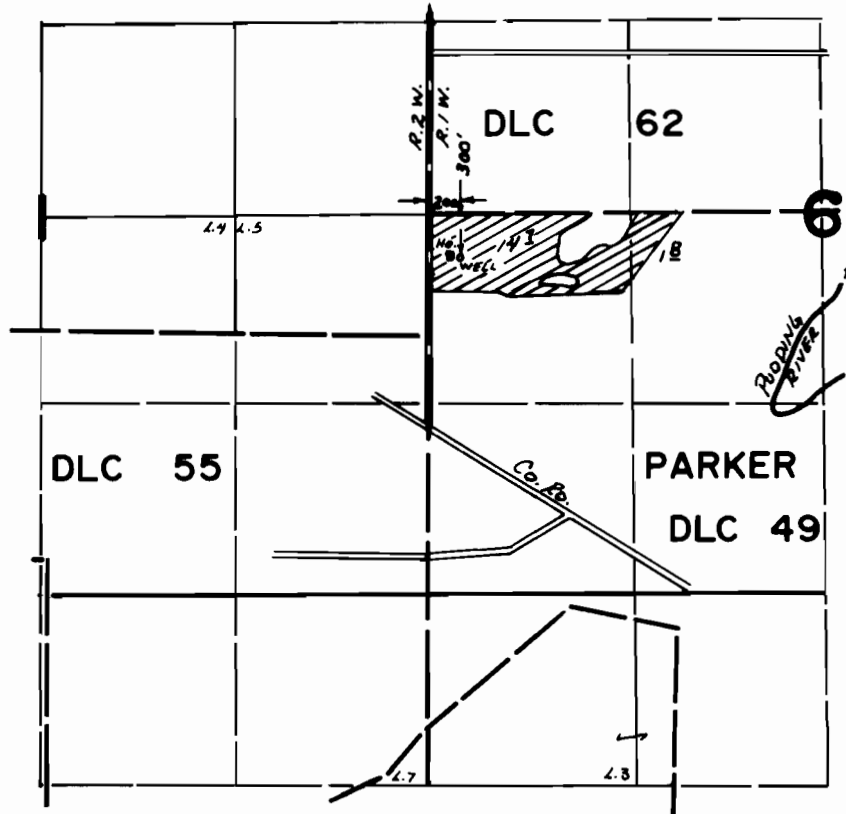

FINAL PROOF SURVEY UNDER

Application No. G-5765 Permit No. G-5017
IN NAME OF

MAURICE NISSEN

Surveyed OCT. 7 1976, by L. TOLL