


T.5&6S.R.2W.W.M.

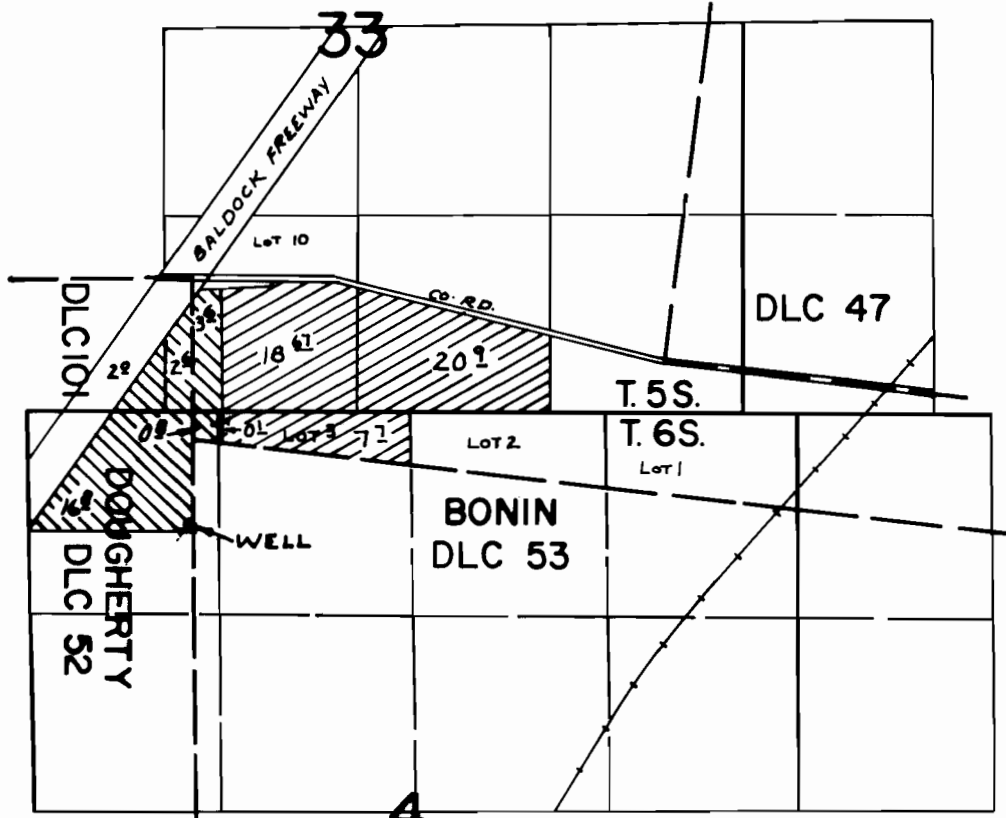

WELL LOC: 580' S. & 20' W. FROM N.W. COR. BONIN DLC 53

 PRIMARY
SUPPLEMENTAL

FINAL PROOF SURVEY UNDER

Application No. *G-5835* Permit No. *G-6343*
IN NAME OF

JAMES F. BUTSCH

Surveyed *AUG. 4, 1976*, by *R. MUCKEN*