T.6S.,R.1W.,W.M.

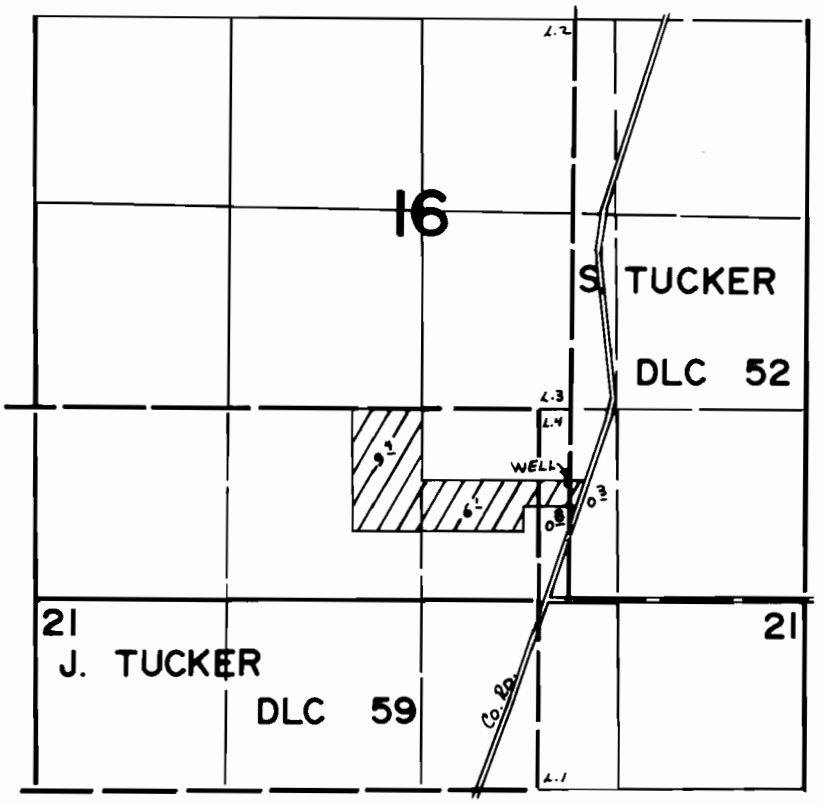

WELL LOC: 800'N AND 1000'E FROM S 1/4 COR. SEC. 16

FINAL PROOF SURVEY
UNDER

Application No. G-6011 Permit No. G-5677
IN NAME OF

LESTER HARPOLE, JR.

Surveyed Aug. 9 19 76, by L. Toll

DEN-1LL-76