


T.5S.,R.2&3W.,W.M.

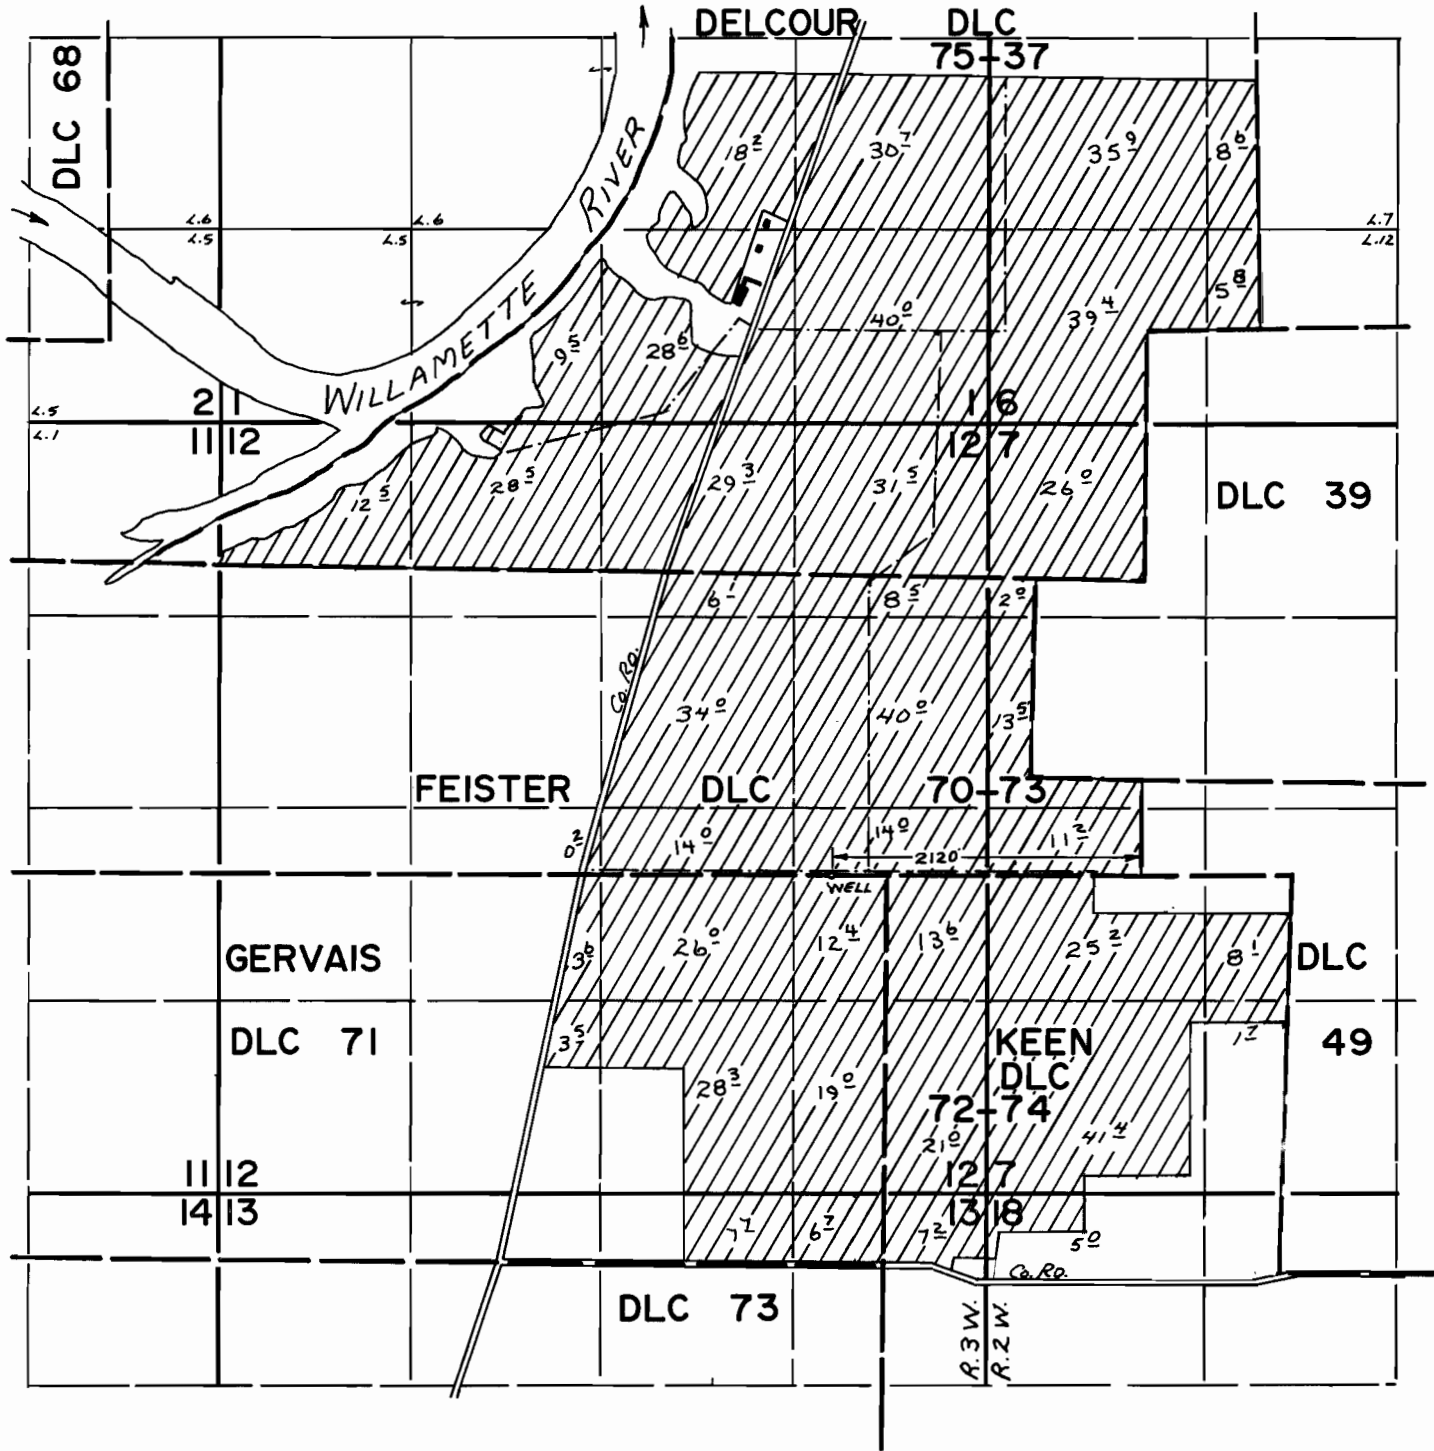

FINAL PROOF SURVEY
UNDER

Application No. G-6026 Permit No. G-5713
IN NAME OF

----- RIVER BEND FARM -----

Surveyed June 1, 1976 by L. Toll -----