# T.3&4S.,R.2W.,W.M.

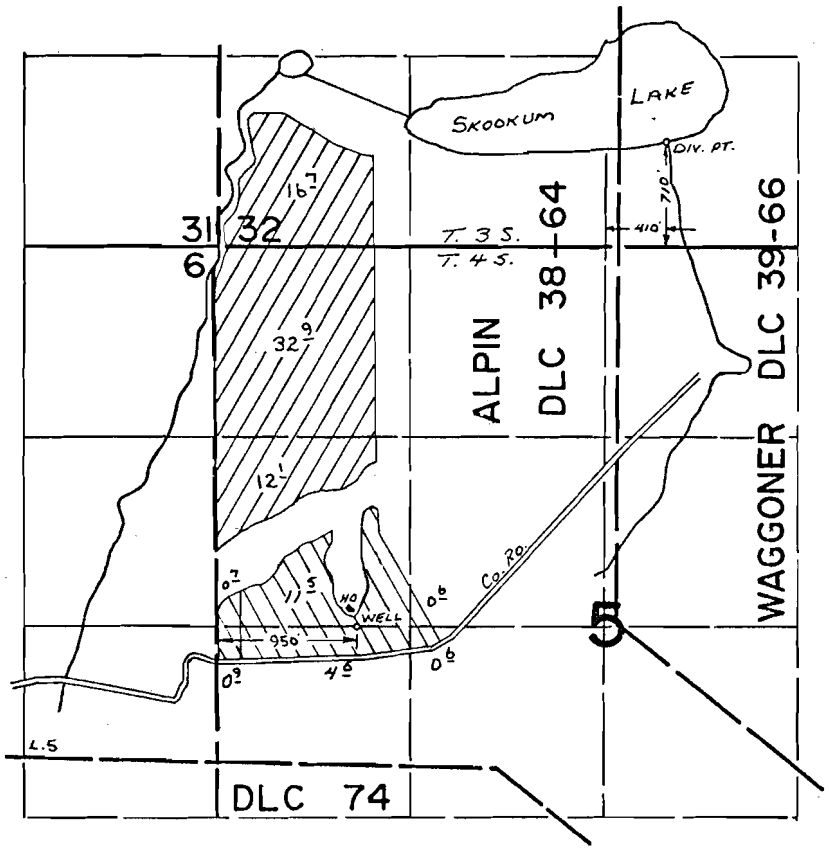


## FINAL PROOF SURVEY
UNDER

Application No. G-7052 50594 Permit No. G-6537 38236

IN NAME OF

JOHN SHAFER

Surveyed April 19, 1976, by L. Toll

DFN-6LL-126