


T. 6 S. R. 2 W. W.M.

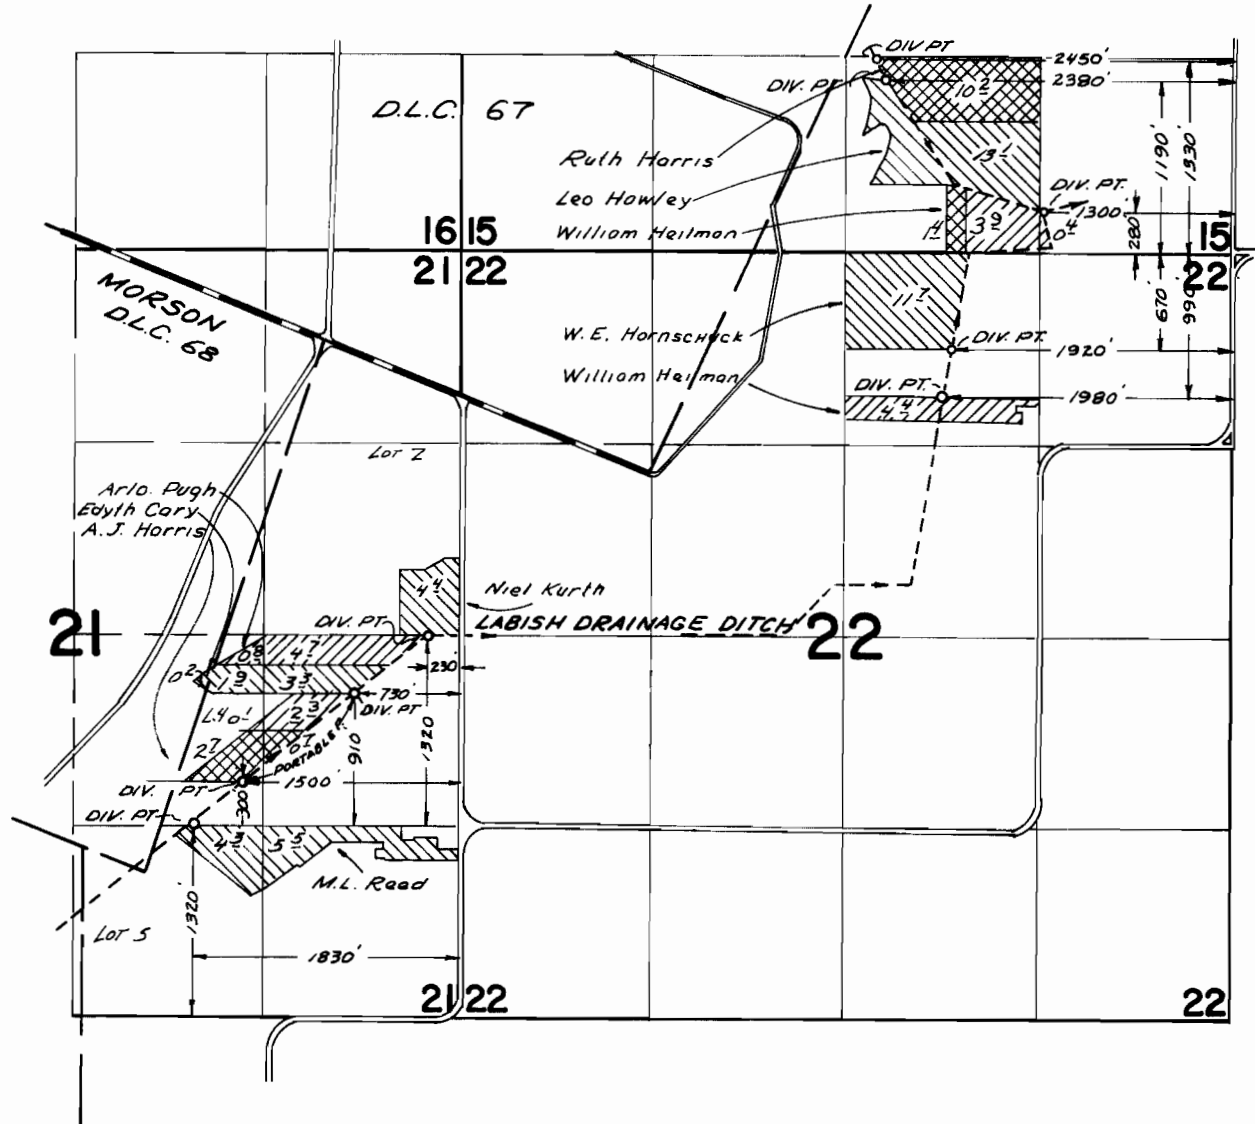

FINAL PROOF SURVEY UNDER

Application No. 37853 Permit No. 28870
IN NAME OF

LAKE LABISH WATER CONTROL DISTRICT

Surveyed May 7, 1968, by V. GARNER